



RIVER ROAD
SEE GRADING PLAN, SHEET 46
VT. ROUTE 67A, RIVER ROAD AND HILLSIDE STREET INTERSECTION

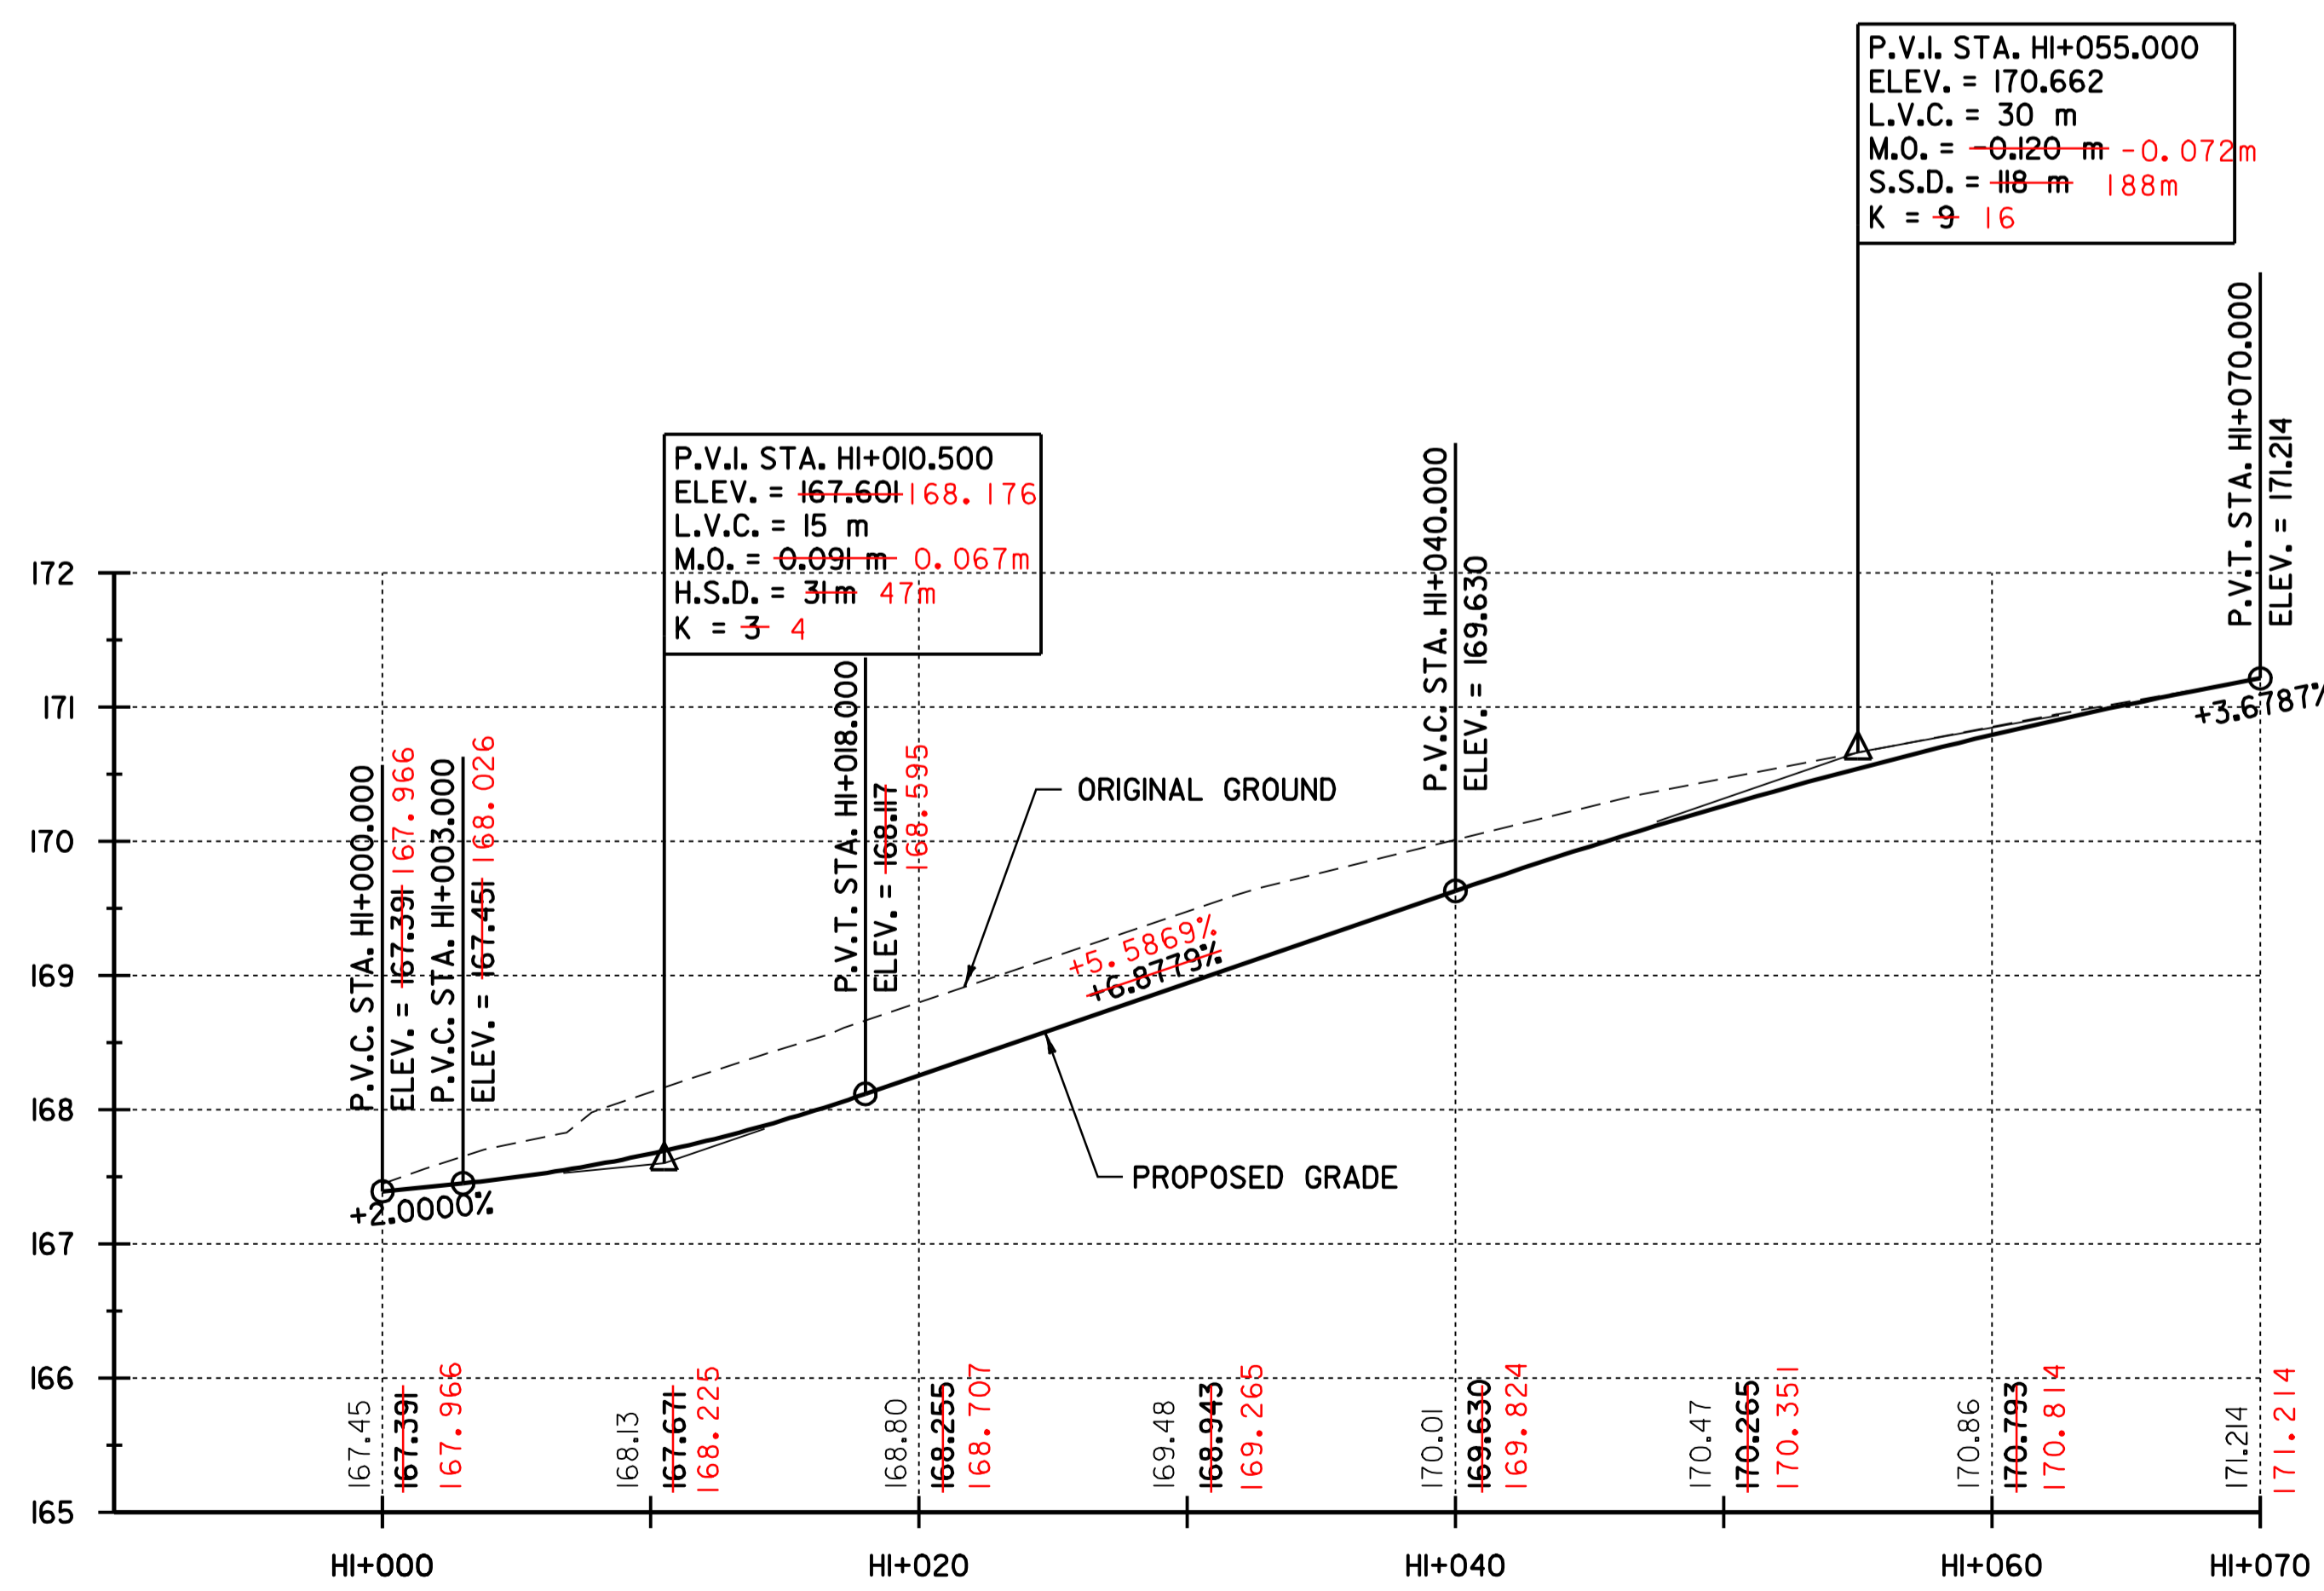

HILLSIDE STREET
SEE GRADING PLAN, SHEET 46
VT. ROUTE 67A, RIVER ROAD AND HILLSIDE STREET INTERSECTION

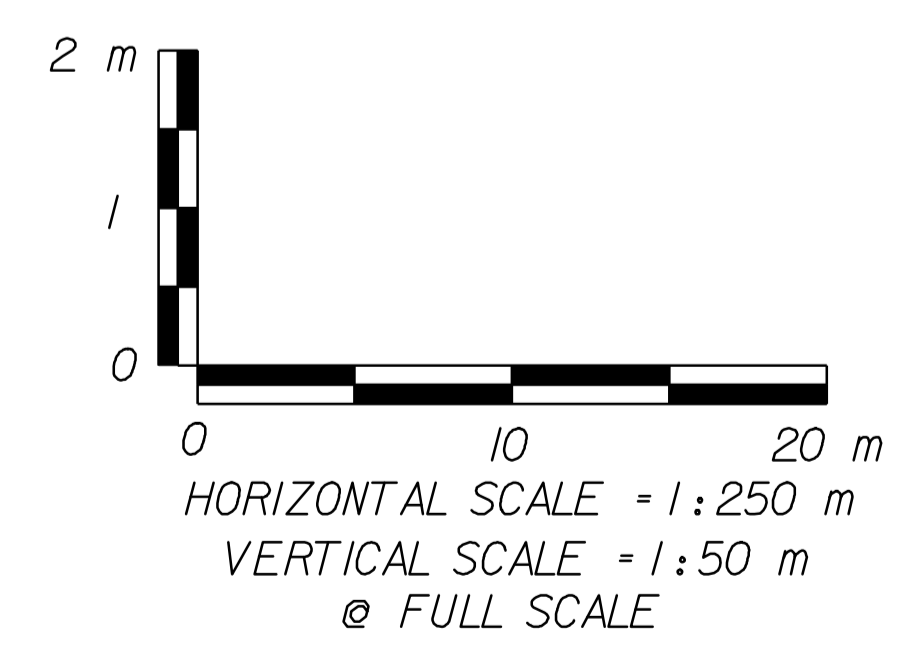

DATUM	
VERTICAL	N/A
HORIZONTAL	NAD83 (1996)

PROFILES	SURVEYED BY	L.R.S.C.	DATE	4/03
	DRAWN BY	C.A.K.	DATE	3/06
	SQUAD LEADER	D.E.G.		
	DESIGN FILE NO.	/pave/95d104/pd104.dgn		
	IPARM FILE	pd104ps.i	DATE PLOTTED	20-AUG-2010 12:
PROJ. NAME	NORTH BENNINGTON			
PROJ. NO.	STP 9646(I)S			
SHEET	45	OF	151	SHEETS