

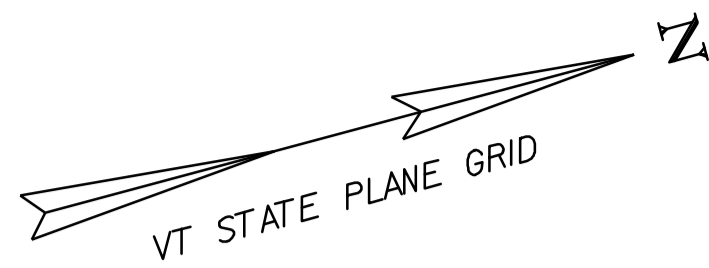
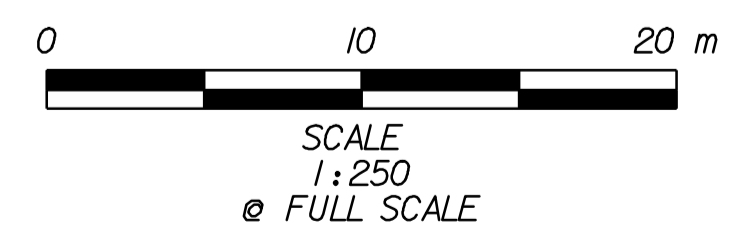
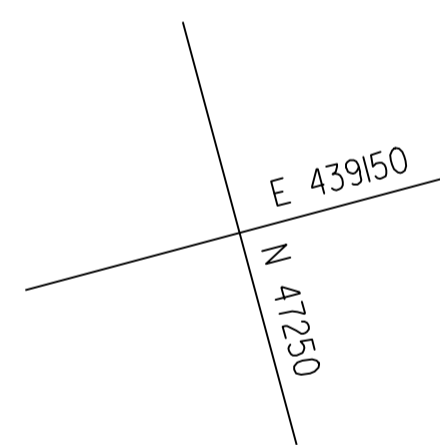


**620.70 SNOW FENCE (MOD. - PDF)**  
 STA. 4+360 - STA. 4+392 LT (32 m)  
 STA. 4+360 - STA. 4+402 RT (42 m)  
 STA. 4+407 - STA. 4+520 LT (113 m)  
 STA. 4+417 - STA. 4+520 RT (105 m)

**649.51 GEOTEXTILE FOR SILT FENCE**  
 STA. 4+360 - STA. 4+402 RT (42 m)  
 STA. 4+417 - STA. 4+520 RT (105 m)

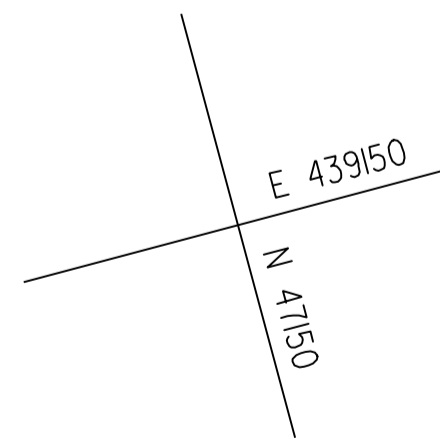

LEGEND	
	PDF - PROJECT DEMARCATION FENCE
	SILT FENCE
	CULVERT INLET PROTECTION
	DRAINAGE STRUCTURE PROTECTION
	CHECK DAM - STONE

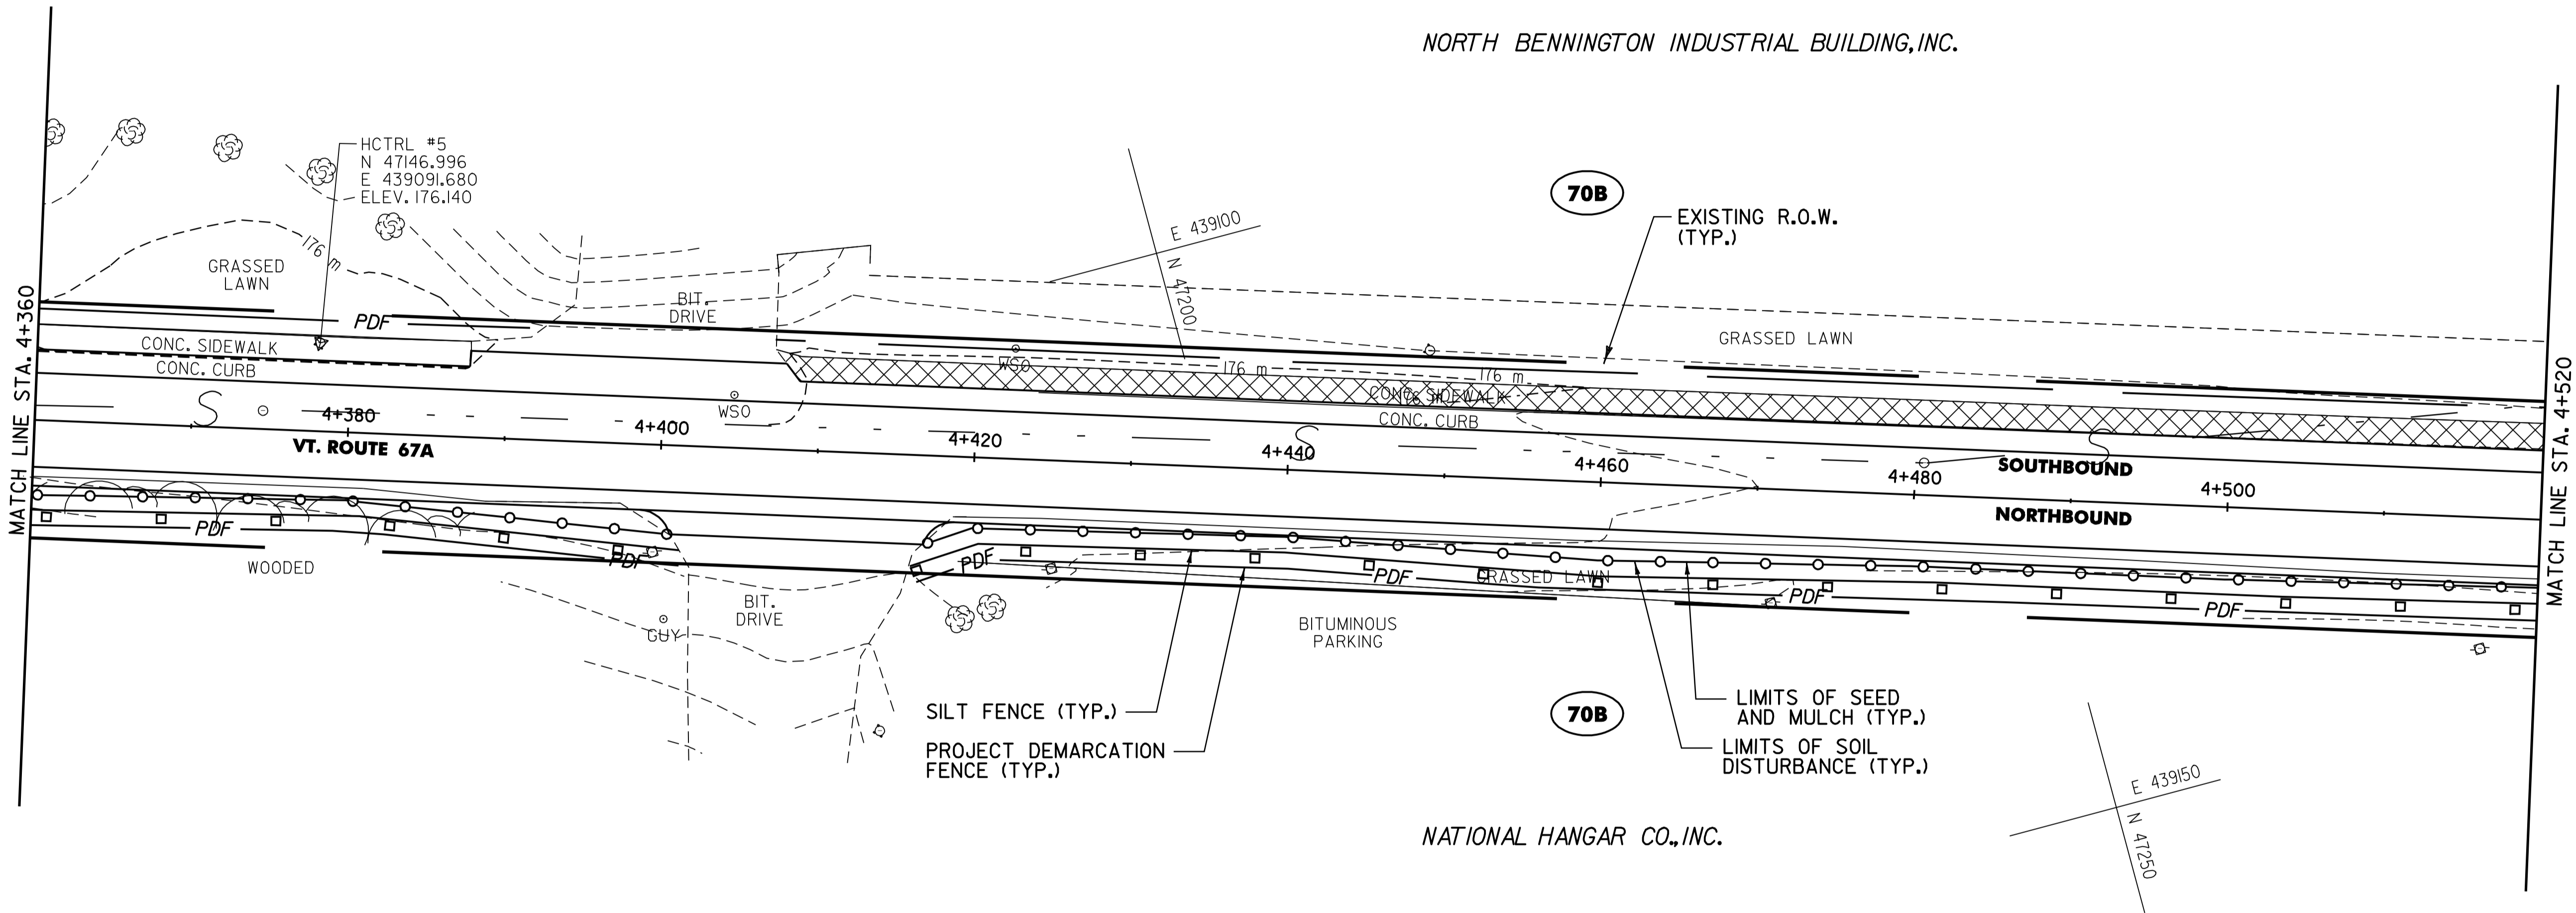

DATUM	
VERTICAL	N/A
HORIZONTAL	NAD83 (1996)

LEGEND	
	MAP UNIT TYPE (SEE SHEET 47 FOR DETAILS)
	SOIL LINE BOUNDARY
	WETLAND / RIPARIAN BOUNDARY
	WETLAND BUFFER
	RIPARIAN BUFFER

**EROSION PREVENTION & SEDIMENT CONTROL PLAN #7**

SURVEYED BY	L.R.S.C.	DATE	4/03
DRAWN BY	C.A.K.	DATE	3/06
SQUAD LEADER	D.E.G.		
DESIGN FILE NO.	/pave/95dl04/pdl04.dgn		
IPARM FILE	pdl04epscp7.i	DATE PLOTTED	30-AUG-2010 12:30
PROJ. NAME	NORTH BENNINGTON		
PROJ. NO.	STP 9646(1)S		
SHEET 71	OF 151	SHEETS	