


**LEGEND**

<b>XXX</b>	MAP UNIT TYPE (SEE SHEET 47 FOR DETAILS)
- VEG - - -	SOIL LINE BOUNDARY
---	WETLAND / RIPARIAN BOUNDARY
- - - - -	WETLAND BUFFER
- . . . .	RIPARIAN BUFFER

DATUM	
VERTICAL	N/A
HORIZONTAL	NAD83 (1996)

STA. 3+550 O/S LT NEW  
3'x3' DI, 18" DIA PIPE CONNECTED  
TO DIAT STA. 3+555.4 O/S RT

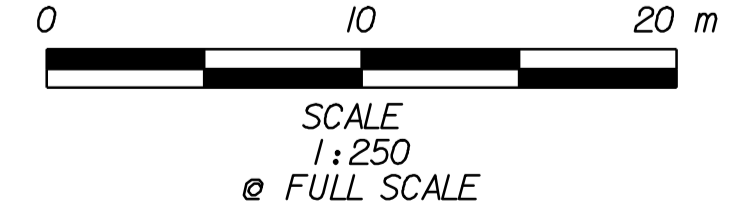

**FINAL CONDITIONS PLAN #1**

SURVEYED BY	L.R.S.C.	DATE	4/03
DRAWN BY	C.A.K.	DATE	3/06
SQUAD LEADER	D.E.G.		
DESIGN FILE NO.	/pave/95dl04/pdl04.dgn		
IPARM FILE	pdl04fcp1.i	DATE PLOTTED	30-AUG-2010 12
PROJ. NAME	NORTH BENNINGTON		
PROJ. NO.	STP 9646(I)S		
SHEET	77 OF 151	SHEETS	