


HCTRL #2
N 46502.436
E 439042.702
ELEV. 168.826

HCTRL #3
N 46649.654
E 439019.927
ELEV. 170.953

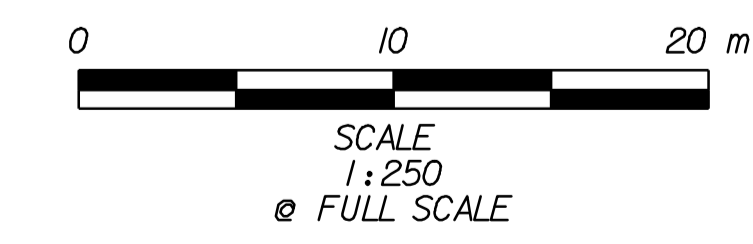

DATUM	
VERTICAL	N/A
HORIZONTAL	NAD83 (1996)

LEGEND	
(XXX)	MAP UNIT TYPE (SEE SHEET 47 FOR DETAILS)
---	SOIL LINE BOUNDARY
---	WETLAND / RIPARIAN BOUNDARY
---	WETLAND BUFFER
---	RIPARIAN BUFFER

FINAL CONDITIONS PLAN #3

SURVEYED BY	L.R.S.C.	DATE	4/03
DRAWN BY	C.A.K.	DATE	3/06
SQUAD LEADER	D.E.G.		
DESIGN FILE NO.	/pave/95dl04/pdl04.dgn		
IPARM FILE	pdl04fcp3.i	DATE PLOTTED	30-AUG-2010 12:00
PROJ. NAME	NORTH BENNINGTON		
PROJ. NO.	STP 9646(IIS)		
SHEET	79 OF 151	SHEETS	