


VT. ROUTE 67A
 MM 3.317 = STA. 5+338.194
 END STP 9646(I)S

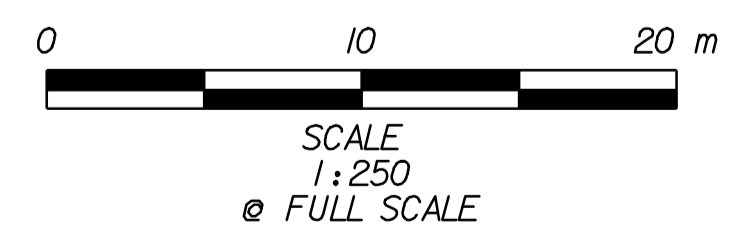

DATUM	
VERTICAL	N/A
HORIZONTAL	NAD83 (1996)

LEGEND	
XXX	MAP UNIT TYPE (SEE SHEET 47 FOR DETAILS)
---	SOIL LINE BOUNDARY
---	WETLAND / RIPARIAN BOUNDARY
---	WETLAND BUFFER
---	RIPIARIAN BUFFER

**FINAL
 CONDITIONS
 PLAN #12**

SURVEYED BY	L.R.S.C.	DATE	4/03
DRAWN BY	C.A.K.	DATE	3/06
SQUAD LEADER	D.E.G.		
DESIGN FILE NO.	/pave/95dl04/pdl04.dgn		
IPARM FILE	pd104fcp12.1	DATE PLOTTED	20-AUG-2010 12:00
PROJ. NAME	NORTH BENNINGTON		
PROJ. NO.	STP 9646(I)S		
SHEET	88 OF 151	SHEETS	