

675.50 REMOVING SIGNS  
AS SHOWN - 6

675.60 ERECTING SALVAGED SIGNS  
AS SHOWN - 1


646.40 DURABLE 100 mm WHITE LINE (THERMOPLASTIC)  
(ALL LINES WILL INCLUDE EDGE LINE BREAKS AND RADIUS FOR TOWN HIGHWAYS)  
VT. ROUTE 67A:  
STA. 3+560.0 - STA. 3+720.0 LT & RT

646.41 DURABLE 100 mm YELLOW LINE (THERMOPLASTIC)  
(ALL LINES WILL INCLUDE C/L BREAKS FOR TOWN HIGHWAYS) S=SOLID, D=DASHED  
VT. ROUTE 67A:  
STA. 3+560.0 - STA. 3+720.0 LT S C RT S

646.42 DURABLE 200 mm WHITE LINE (THERMOPLASTIC)  
VT. ROUTE 67A:  
STA. 3+646.2 - STA. 3+649.8 RT, SHOULDER HATCHING (11.0 m)  
STA. 3+703.3 - STA. 3+706.9 RT, SHOULDER HATCHING (11.0 m)


646.60 TEMPORARY 100 mm WHITE LINE (PAINT)  
(ALL LINES WILL INCLUDE EDGE LINE BREAKS AND RADIUS FOR TOWN HIGHWAYS)  
VT. ROUTE 67A:  
STA. 3+560.0 - STA. 3+720.0 LT & RT

646.61 TEMPORARY 100 mm YELLOW LINE (PAINT)  
(ALL LINES WILL INCLUDE C/L BREAKS FOR TOWN HIGHWAYS) S=SOLID, D=DASHED  
VT. ROUTE 67A:  
STA. 3+560.0 - STA. 3+720.0 LT S C RT S

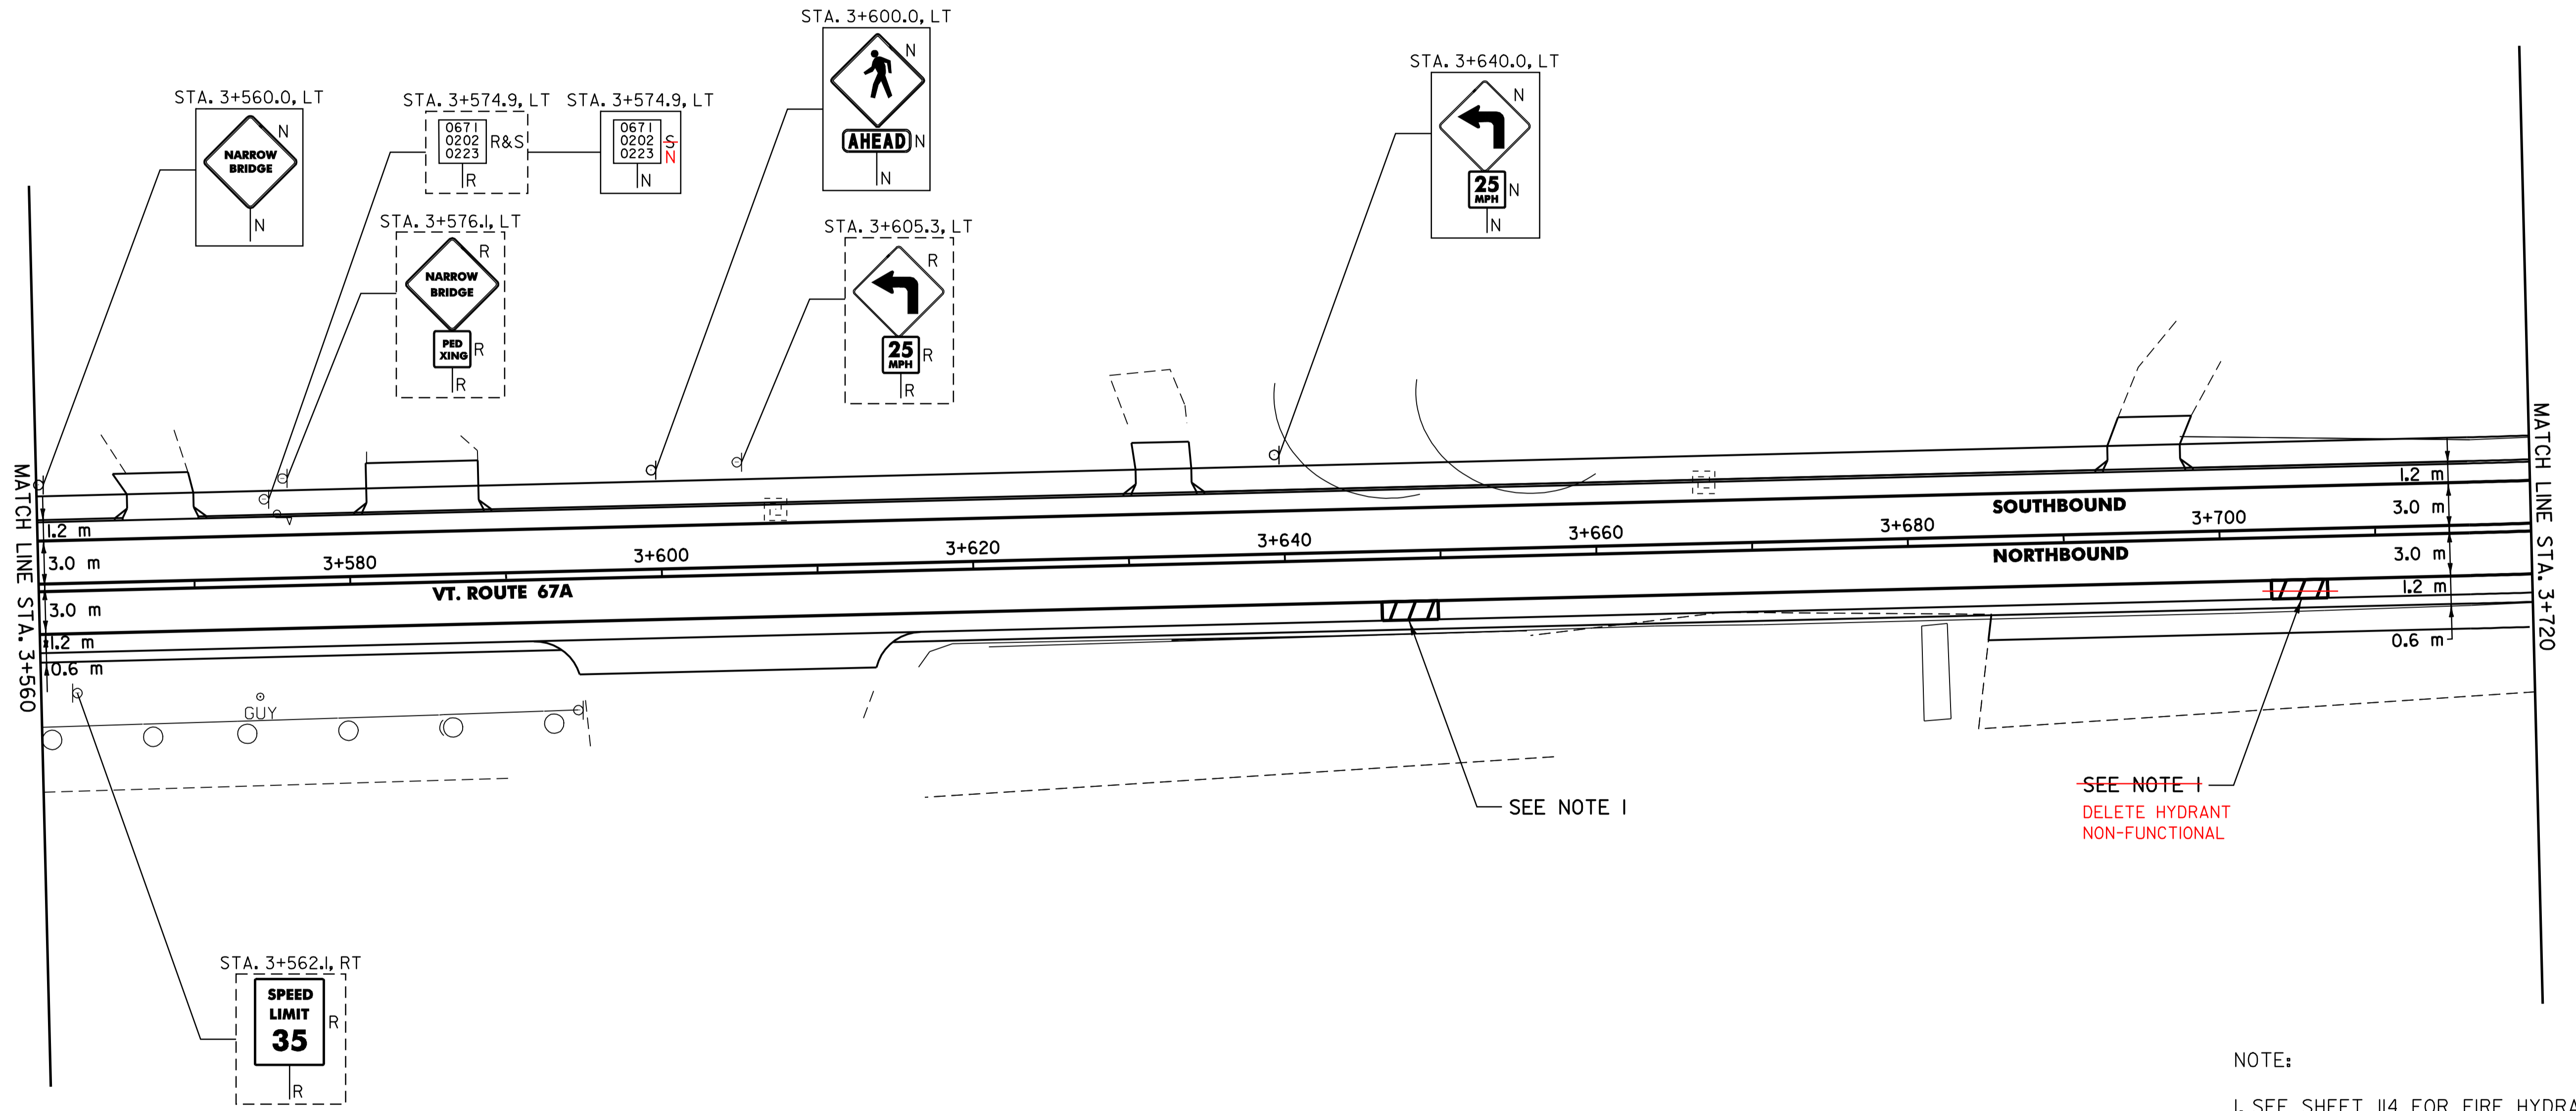

SEE NOTE 1  
DELETE HYDRANT  
NON-FUNCTIONAL

NOTE:  
1. SEE SHEET 114 FOR FIRE HYDRANT PAVEMENT MARKING DETAIL.

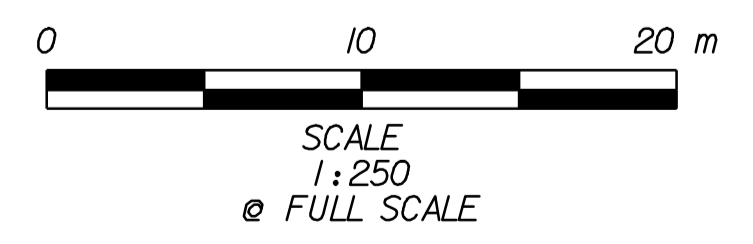

DATUM	
VERTICAL	N/A
HORIZONTAL	NAD83 (1996)

**SIGN LEGEND**  
R= REMOVE  
S= SALVAGE  
N= NEW  
RET= RETAIN  
B-B= BACK TO BACK  
EXISTING= - - - - -  
NEW= \_\_\_\_\_

<h2>SIGNING &amp; STRIPING PLAN SHEET #2</h2>	SURVEYED BY	L.R.S.C.	DATE	4/03
	DRAWN BY	C.A.K.	DATE	3/06
	SQUAD LEADER	D.E.G.		
	DESIGN FILE NO.	/pave/95d104/pdl04.dgn		
	IPARM FILE	pdl04ssps02.i	DATE PLOTTED	20-AUG-2010 12:00
PROJ. NAME	NORTH BENNINGTON			
PROJ. NO.	STP 9646(1)S			
SHEET 98 OF 151	SHEETS			