


DATUM	
VERTICAL	N/A
HORIZONTAL	NAD83 (1996)

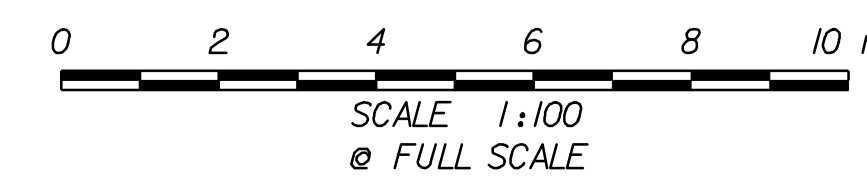

VT. RTE. 67A CROSS SECTIONS SHEET 4	SURVEYED BY <u>L.R.S.C.</u> DATE <u>4/03</u>
	DRAWN BY <u>C.A.K.</u> DATE <u>3/06</u>
	SQUAD LEADER <u>D.E.G.</u>
	DESIGN FILE NO. <u>/pave/95dl04/pdl04.dgn</u>
	IPARM FILE <u>pdl04xs04.i</u> DATE <u>20-AUG-2010 12:30</u>
PROJ. NAME	NORTH BENNINGTON
PROJ. NO.	STP 9646(1)S
SHEET 119 OF 151	SHEETS