


|            |              |
|------------|--------------|
| DATUM      |              |
| VERTICAL   | N/A          |
| HORIZONTAL | NAD83 (1996) |

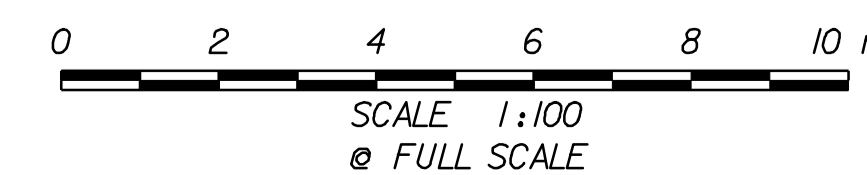

**VT. RTE. 67A  
CROSS  
SECTIONS  
SHEET 5**

|                  |                        |              |                   |
|------------------|------------------------|--------------|-------------------|
| SURVEYED BY      | L.R.S.C.               | DATE         | 4/03              |
| DRAWN BY         | C.A.K.                 | DATE         | 3/06              |
| SQUAD LEADER     | D.E.G.                 |              |                   |
| DESIGN FILE NO.  | /pave/95dl04/pdl04.dgn |              |                   |
| IPARM FILE       | pdl04xs05.i            | DATE PLOTTED | 20-AUG-2010 12:30 |
| PROJ. NAME       | NORTH BENNINGTON       |              |                   |
| PROJ. NO.        | STP 9646(I)S           |              |                   |
| SHEET 120 OF 151 | SHEETS                 |              |                   |