


| | |
|------------|--------------|
| DATUM | |
| VERTICAL | N/A |
| HORIZONTAL | NAD83 (1996) |

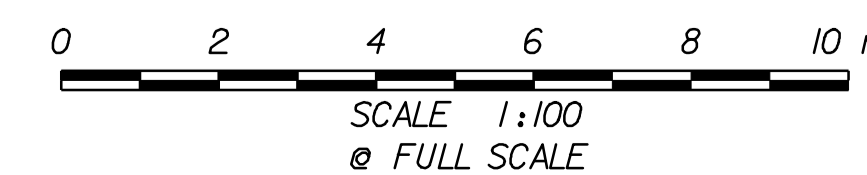

**VT. RTE. 67A
CROSS
SECTIONS
SHEET 6**

| | | | |
|------------------|------------------------|--------------|-------------------|
| SURVEYED BY | L.R.S.C. | DATE | 4/03 |
| DRAWN BY | C.A.K. | DATE | 3/06 |
| SQUAD LEADER | D.E.G. | | |
| DESIGN FILE NO. | /pave/95dl04/pdl04.dgn | | |
| IPARM FILE | pdl04xs06.i | DATE PLOTTED | 20-AUG-2010 12:30 |
| PROJ. NAME | NORTH BENNINGTON | | |
| PROJ. NO. | STP 9646(1)S | | |
| SHEET 121 OF 151 | | | SHEETS |