


DATUM	
VERTICAL	N/A
HORIZONTAL	NAD83 (1996)

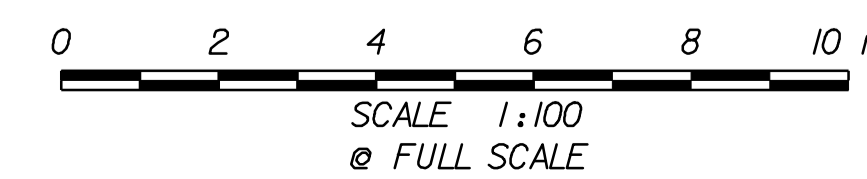

VT. RTE. 67A CROSS SECTIONS SHEET 19	SURVEYED BY	L.R.S.C.	DATE	4/03
	DRAWN BY	C.A.K.	DATE	3/06
	SQUAD LEADER	D.E.G.		
	DESIGN FILE NO.	/pave/95dl04/pdl04.dgn		
	IPARM FILE	pdl04xsl9.1	DATE PLOTTED	20-AUG-2010 12:00
PROJ. NAME	NORTH BENNINGTON			
PROJ. NO.	STP 9646(IIS)			
SHEET 134 OF 151	SHEETS			