


DATUM	
VERTICAL	N/A
HORIZONTAL	NAD83 (1996)

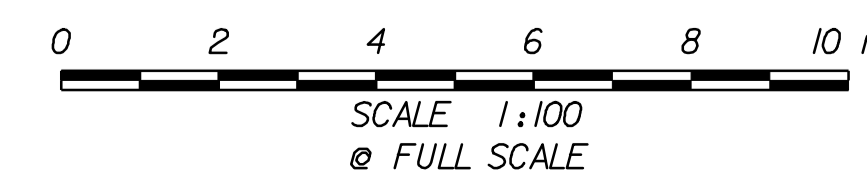

**VT. RTE. 67A
CROSS
SECTIONS
SHEET 21**

SURVEYED BY L.R.S.C. DATE 4/03
 DRAWN BY C.A.K. DATE 3/06
 SQUAD LEADER D.E.G.
 DESIGN FILE NO. /pave/95dl04/pdl04.dgn
 IPARM FILE pdl04xs21.i DATE 30-AUG-2010 12:30
 PROJ. NAME NORTH BENNINGTON
 PROJ. NO. STP 9646(I)S
 SHEET 136 OF 151 SHEETS