


DATUM
VERTICAL N/A
HORIZONTAL NAD83 (1996)

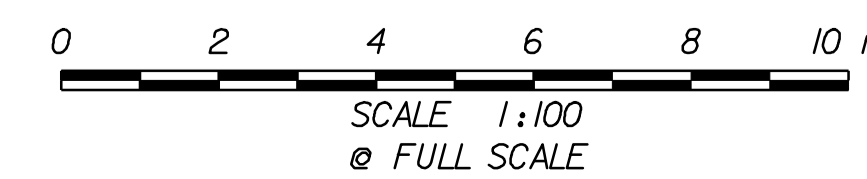

**VT. RTE. 67A
CROSS
SECTIONS
SHEET 23**

SURVEYED BY L.R.S.C. DATE 4/03
DRAWN BY C.A.K. DATE 3/06
SQUAD LEADER D.E.G.
DESIGN FILE NO. /pave/95dl04/pdl04.dgn
IPARM FILE pdl04xs23.i DATE 20-AUG-2010 12:30
PROJ. NAME NORTH BENNINGTON
PROJ. NO. STP 9646(1)S
SHEET 138 OF 151 SHEETS