


DATUM  
VERTICAL N/A  
HORIZONTAL NAD83 (1996)

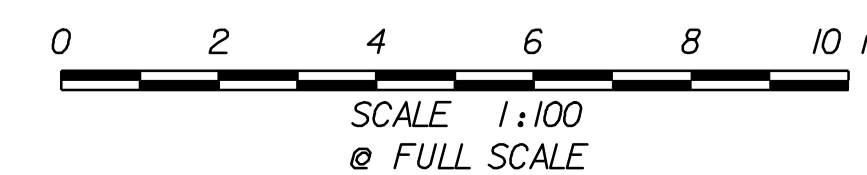

**VT. RTE. 67A  
CROSS  
SECTIONS  
SHEET 25**

SURVEYED BY L.R.S.C. DATE 4/03  
DRAWN BY C.A.K. DATE 3/06  
SQUAD LEADER D.E.G.  
DESIGN FILE NO. /pave/95dl04/pdl04.dgn  
IPARM FILE pdl04xs25.i DATE 30-AUG-2010 12:30  
PROJ. NAME NORTH BENNINGTON  
PROJ. NO. STP 9646(1)S  
SHEET 140 OF 151 SHEETS