


DATUM	
VERTICAL	N/A
HORIZONTAL	NAD83 (1996)

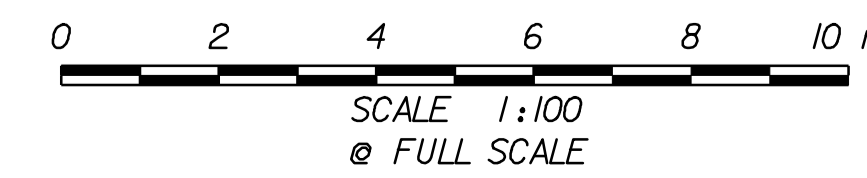

<b>VT. RTE. 67A CROSS SECTIONS SHEET 27</b>	SURVEYED BY	<u>L.R.S.C.</u>	DATE	<u>4/03</u>
	DRAWN BY	<u>C.A.K.</u>	DATE	<u>3/06</u>
	SQUAD LEADER	<u>D.E.G.</u>		
	DESIGN FILE NO.	<u>/pave/95d104/pd104.dgn</u>		
	IPARM FILE	<u>pd104xs27.i</u>	DATE PLOTTED	<u>20-AUG-2010 12:30</u>
PROJ. NAME	NORTH BENNINGTON			
PROJ. NO.	STP 9646(1)S			
SHEET 142 OF 151	SHEETS			