


DATUM	
VERTICAL	N/A
HORIZONTAL	NAD83 (1996)

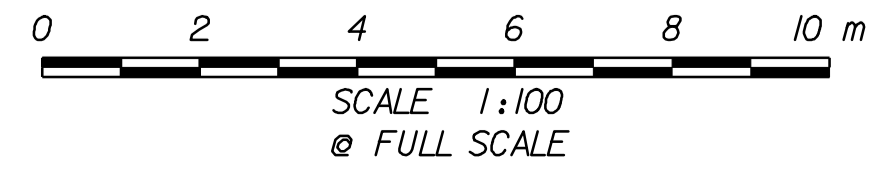

**VT. RTE. 67A
CROSS
SECTIONS
SHEET 28**

SURVEYED BY	<u>L.R.S.C.</u>	DATE	<u>4/03</u>
DRAWN BY	<u>C.A.K.</u>	DATE	<u>3/06</u>
SQUAD LEADER	<u>D.E.G.</u>		
DESIGN FILE NO.	<u>/pave/95di04/pdi04.dgn</u>		
IPARM FILE	<u>pdi04xs28.i</u>	DATE PLOTTED	<u>20-AUG-2010 12:30</u>
PROJ. NAME	NORTH BENNINGTON		
PROJ. NO.	STP 9646(IIS)		
SHEET 143 OF 151		SHEETS	