


DATUM	
VERTICAL	N/A
HORIZONTAL	NAD83 (1996)

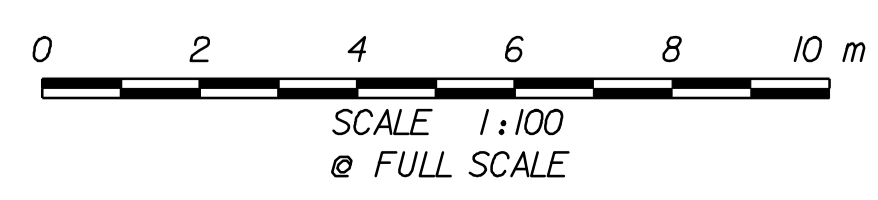

RIVER ROAD CROSS SECTIONS SHEET 1

SURVEYED BY <u>L.R.S.C.</u>	DATE <u>4/03</u>
DRAWN BY <u>C.A.K.</u>	DATE <u>3/06</u>
SQUAD LEADER <u>D.E.G.</u>	
DESIGN FILE NO. <u>/pave/95d104/pd104.dgn</u>	
IPARM FILE <u>pd104xs34.i</u>	DATE PLOTTED <u>20-AUG-2010 12:30</u>
PROJ. NAME <u>NORTH BENNINGTON</u>	
PROJ. NO. <u>STP 9646(IIS)</u>	
SHEET <u>149</u> OF <u>151</u>	SHEETS