


DATUM	
VERTICAL	N/A
HORIZONTAL	NAD83 (1996)

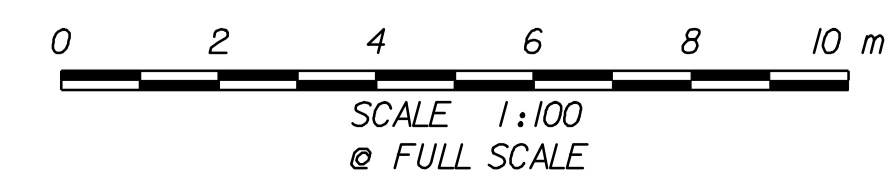

HILLSIDE STREET CROSS SECTIONS SHEET 1

SURVEYED BY	L.R.S.C.	DATE	4/03
DRAWN BY	C.A.K.	DATE	3/06
SQUAD LEADER	D.E.G.		
DESIGN FILE NO.	/pave/95dl04/pdl04.dgn		
IPARM FILE	pdl04xs36.i	DATE PLOTTED	20-AUG-2010 12:30
PROJ. NAME	NORTH BENNINGTON		
PROJ. NO.	STP 9646(I)S		
SHEET 151 OF 151	SHEETS		