




**APPROACH SLAB #1 PLAN**

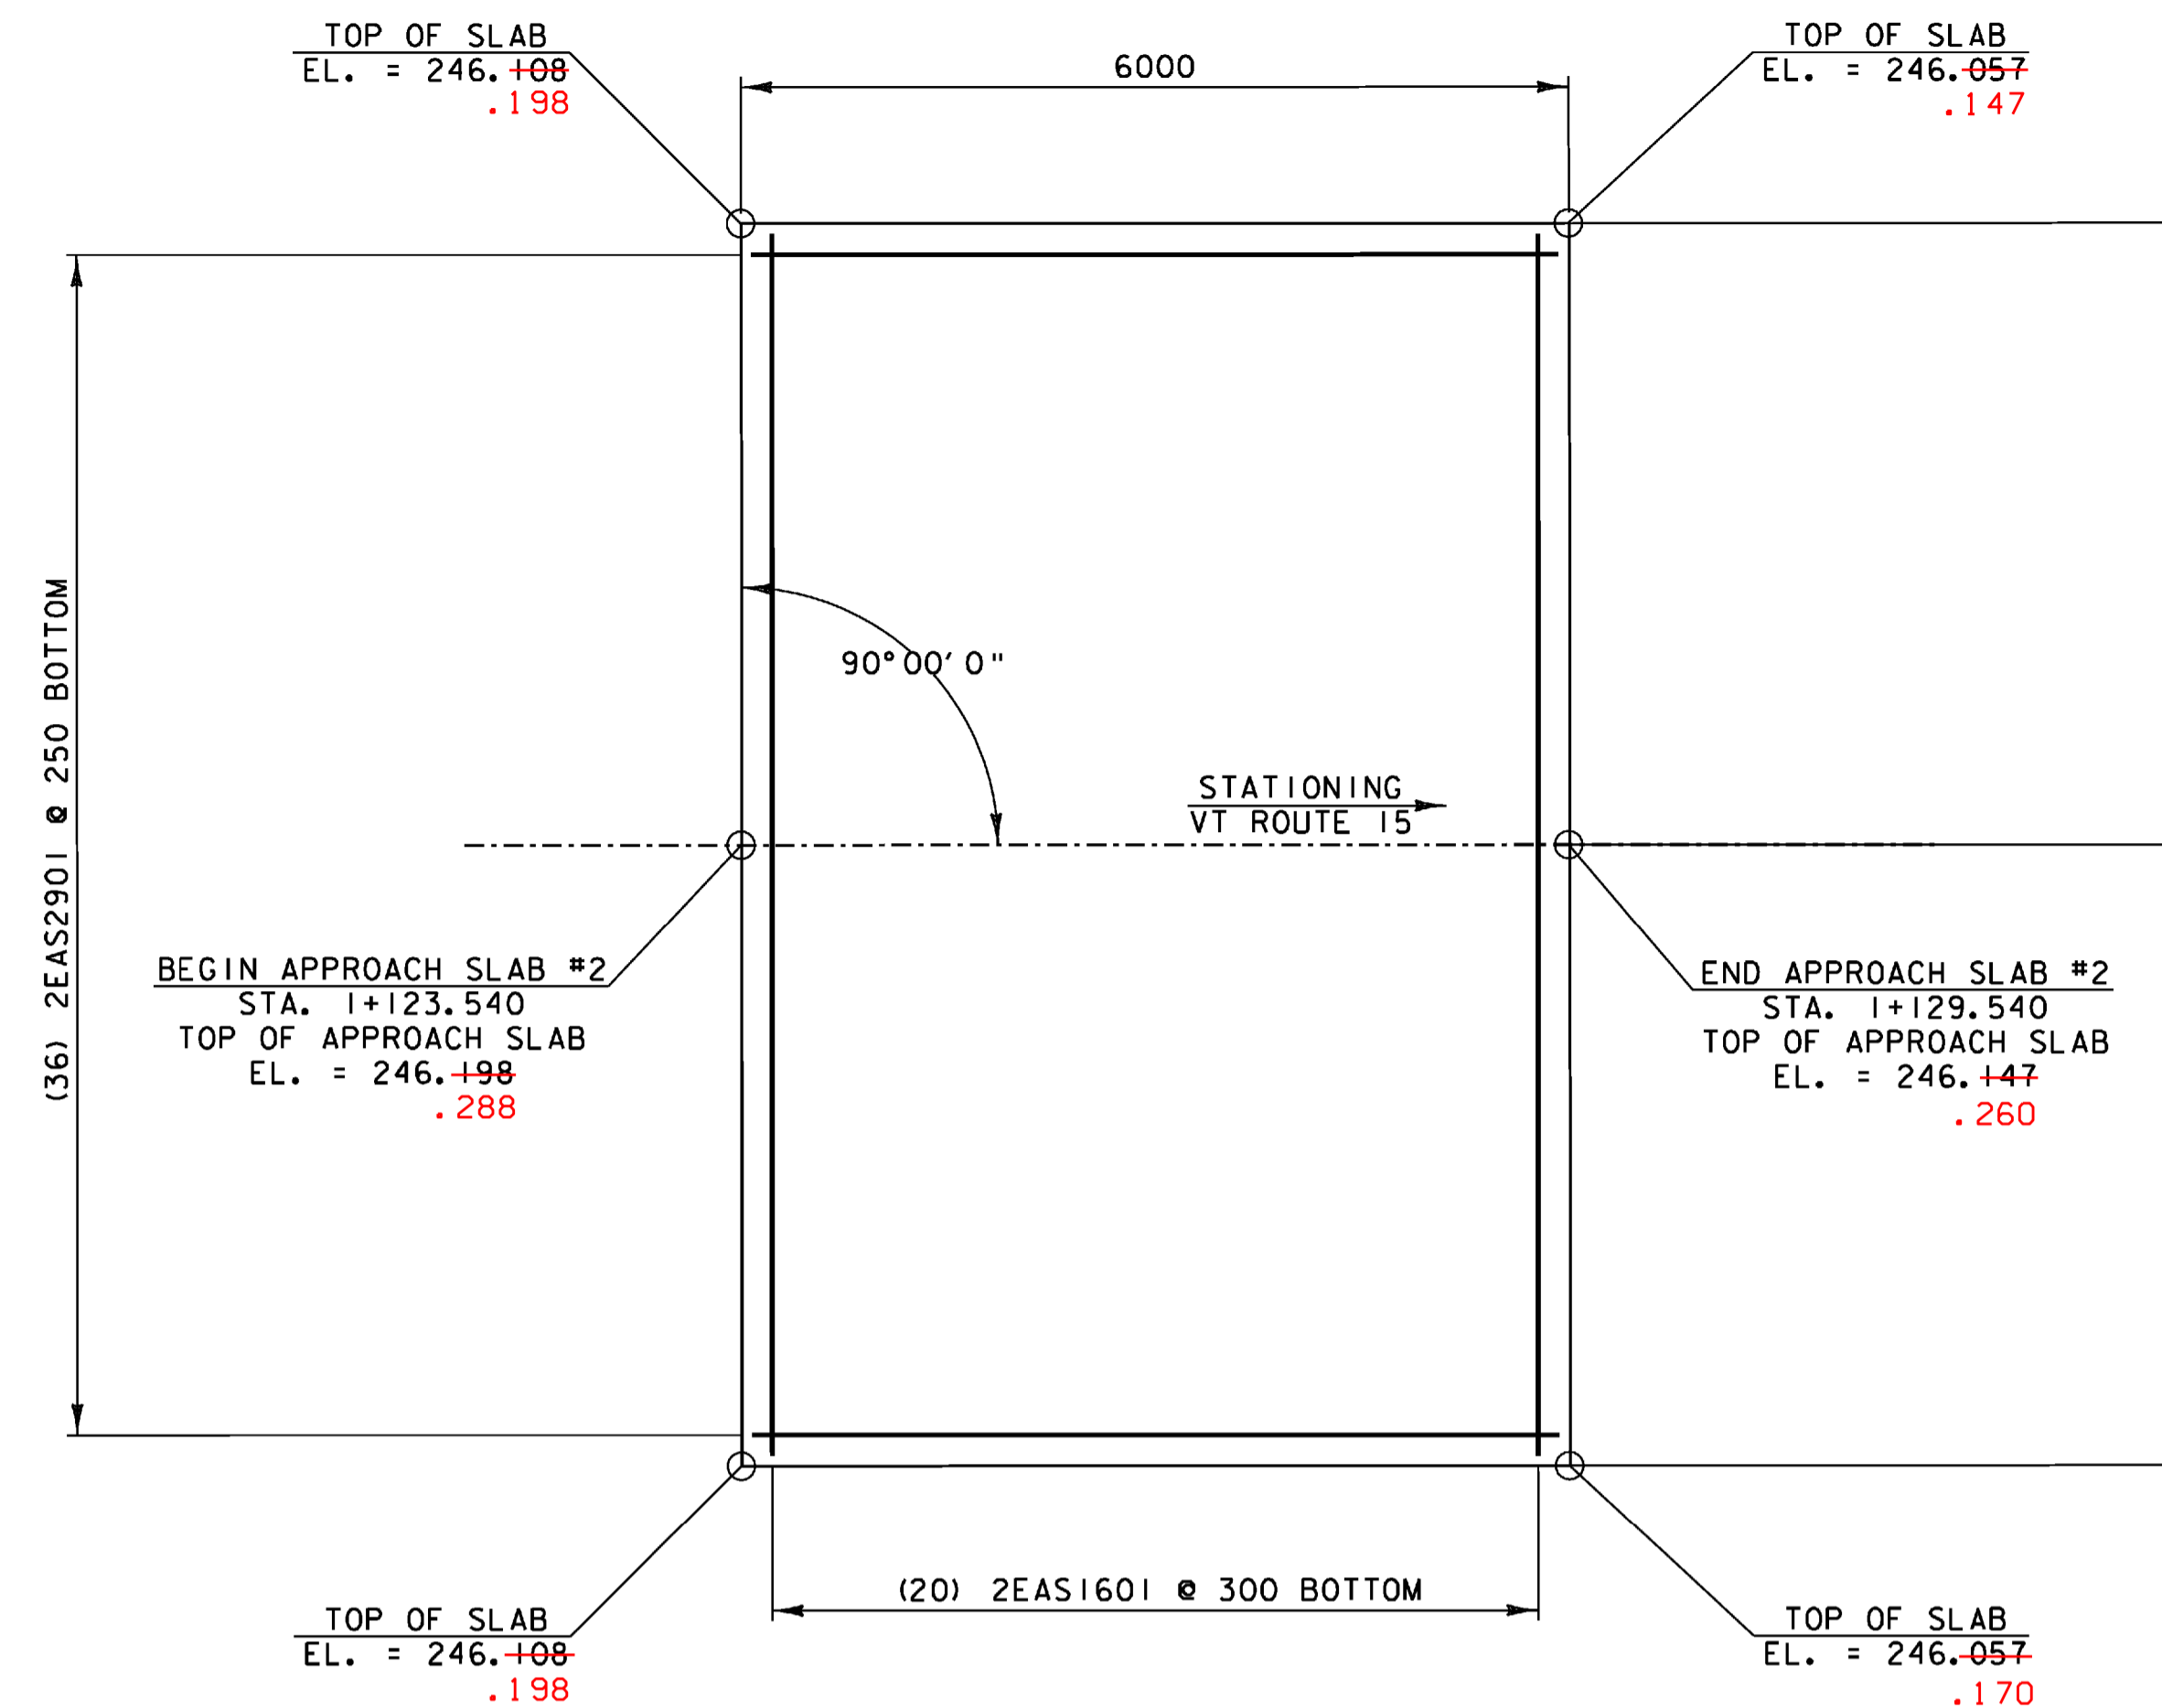

**APPROACH SLAB #2 PLAN**

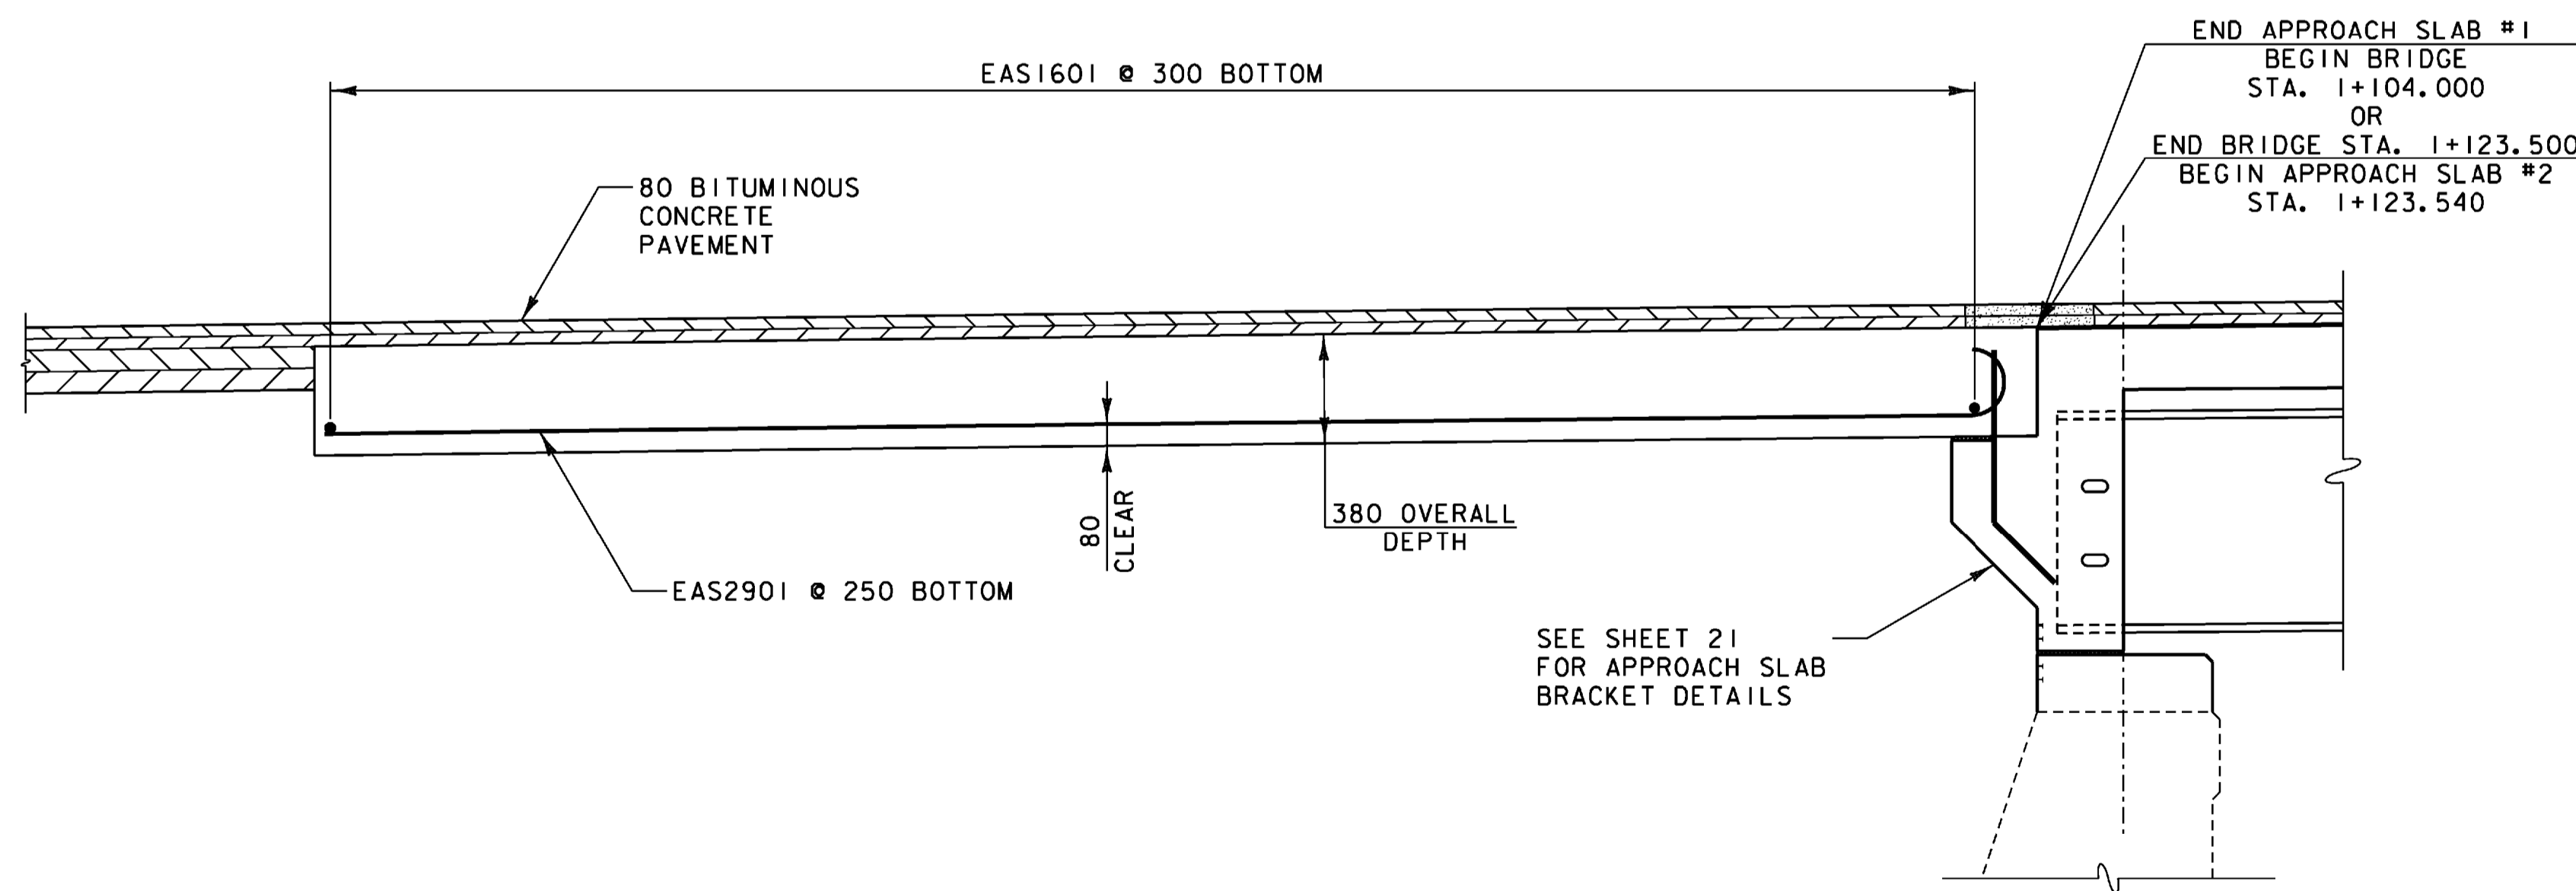

**TYPICAL APPROACH SLAB SECTION**

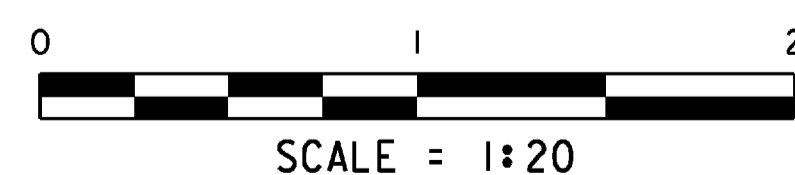

**NOTE:**

- NF = NEAR FACE
- FF = FAR FACE
- EF = EACH FACE
- T&B = TOP AND BOTTOM
- ▲ = CUT TO FIT IN FIELD
- 75 CLR. UNLESS OTHERWISE SPECIFIED ON THE PLANS.
- MAXIMUM LAP LENGTH NOT DETAILED SHALL BE 660.

**STATE OF VERMONT  
AGENCY OF TRANSPORTATION**

Town Of	HARDWICK	Bridge No.	67
Highway No.	VT 15	Log Sta.	
		Surv. Sta.	

**VT 15 OVER COOPER BROOK**

**APPROACH SLAB DETAILS**

Designed By	A.P. GUYETTE	Drawn By	P.G. JARVIS
Checked By	Date	Bridge Design Supervisor	
	E. P. DETRICK	J.W. TUCKER	Date 11/08
PROJECT	HARDWICK	PROJECT NO.	BHF 030-2 (18) S
I.G.C. Info.	DGN#SPEC#		
Bridge Sheet No.		Sheet	31 of 38

**DuBois & King**  
INC.  
engineering    planning    management    development