


DATUM  
 VERTICAL NAVD 88  
 HORIZONTAL NAD 83/92

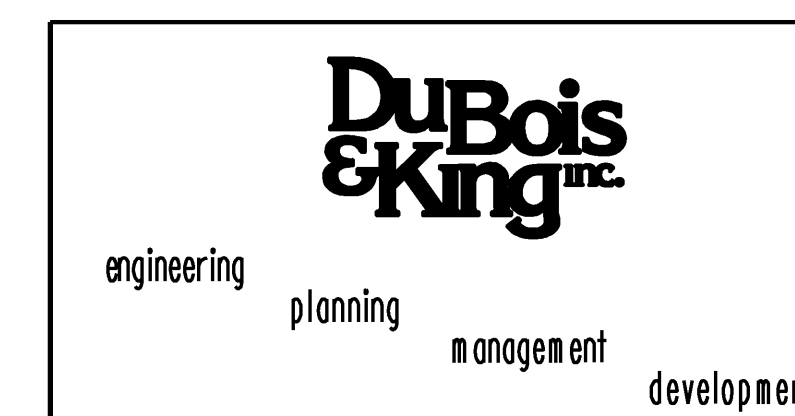

PLOTTED \$\$\$DATE\$\$\$

<b>STATE OF VERMONT AGENCY OF TRANSPORTATION</b>			
Town Of	HARDWICK	Bridge No.	67
Highway No.	VT 15	Log Sta.	
		Surv. Sta.	
<b>VT 15 OVER COOPER BROOK CHANNEL CROSS SECTIONS 1</b>			
Designed By	A.P. GUYETTE	Drawn By	S.J. BIJOLLE
Checked By	Date	Bridge Design Supervisor	Date
	E. P. DETRICK 11/08	J.W. TUCKER	11/08
PROJECT	HARDWICK	PROJECT NO.	BHF 030-2 (18) S
I.G.C. Info. DGN\$SPEC\$			
Bridge Sheet No.	Sheet 37 of 38		