


DATUM  
 VERTICAL NAVD 88  
 HORIZONTAL NAD 83/92

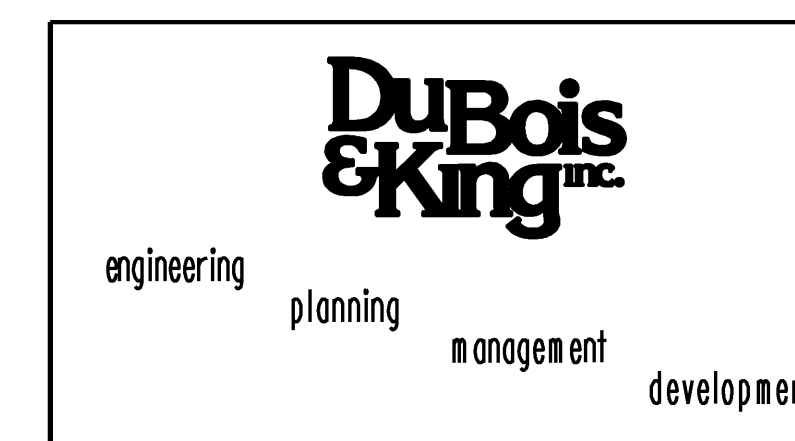

<b>STATE OF VERMONT AGENCY OF TRANSPORTATION</b>			
Town Of	HARDWICK	Bridge No.	67
Highway No.	VT 15	Log Sta.	
		Surv. Sta.	
<b>VT 15 OVER COOPER BROOK CHANNEL CROSS SECTIONS 2</b>			
Designed By	A.P. GUYETTE	Drawn By	
Checked By	Date	Bridge Design Supervisor	
E. P. DETRICK	11/08	J.W. TUCKER	Date 11/08
PROJECT	HARDWICK	PROJECT NO.	BHF 030-2 (18) S
I.G.C. Info. DGN\$SPEC\$		Sheet 38 of 38	
Bridge Sheet No.			

PLOTTED \$\$\$DATE\$\$\$