


*** COLD-IN-PLACE RECYCLING BEGAN AT DORSET MM. 5.420 AND ENDED AT DORSET MM. 6.100**

TEMPORARY 4' YELLOW LINE
(ALL LINES WILL INCLUDE C/L BREAKS FOR TOWN HIGHWAYS) S=SOLID, D=DASHED

	LT	C/L	RT
MM 5.420 - MM 5.450	S	-	D
MM 5.450 - MM 6.100	-	D	-

TEMPORARY 4' WHITE LINE


MM 5.420 - MM 6.100	LT (SOLID)
MM 5.420 - MM 6.100	RT (SOLID)

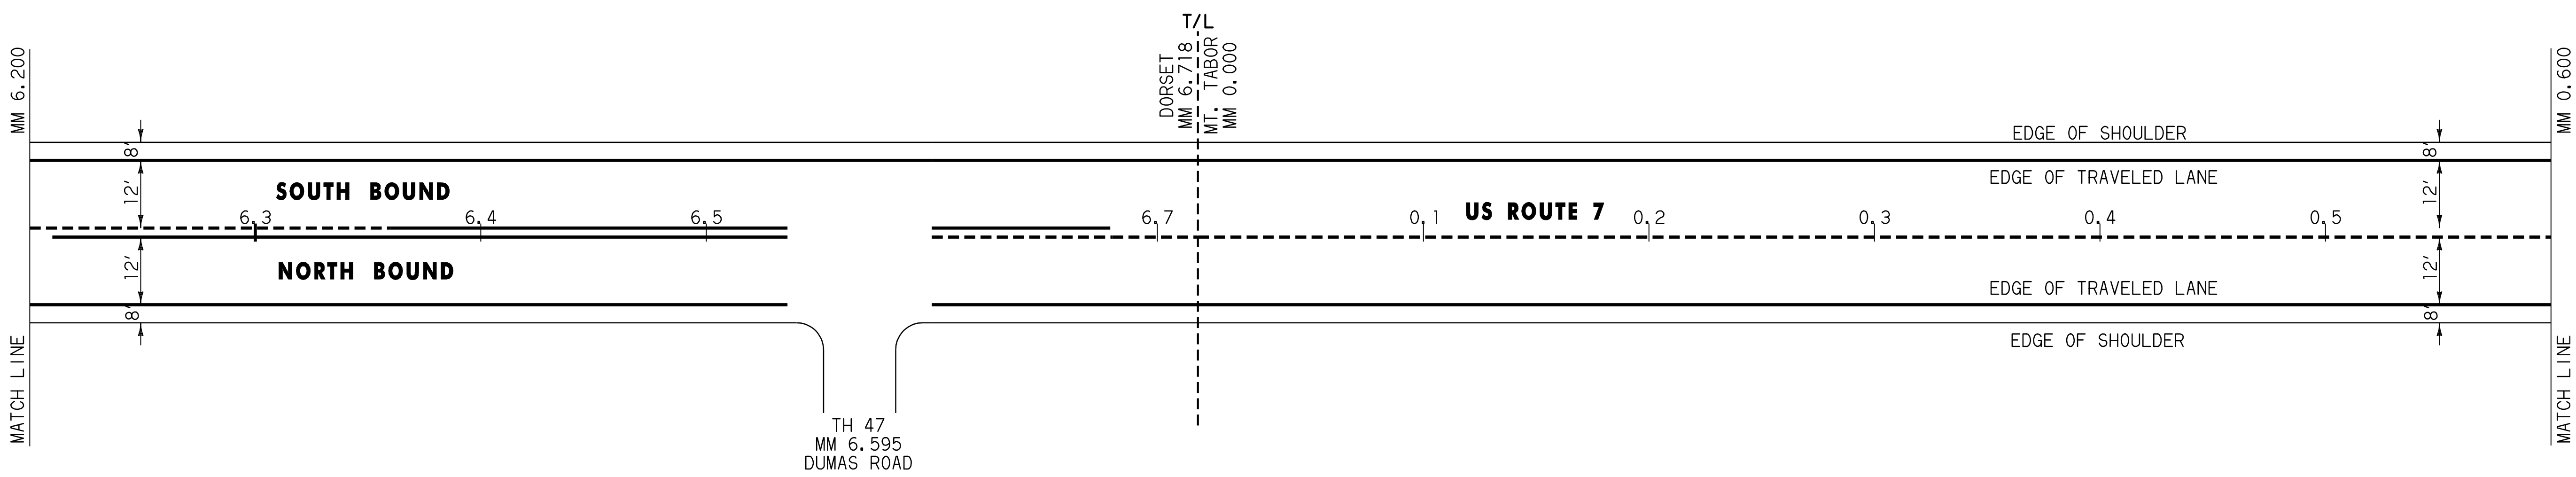

**ARCHIVED
ON CADD**

DATUM

VERTICAL	N/A
HORIZONTAL	N/A

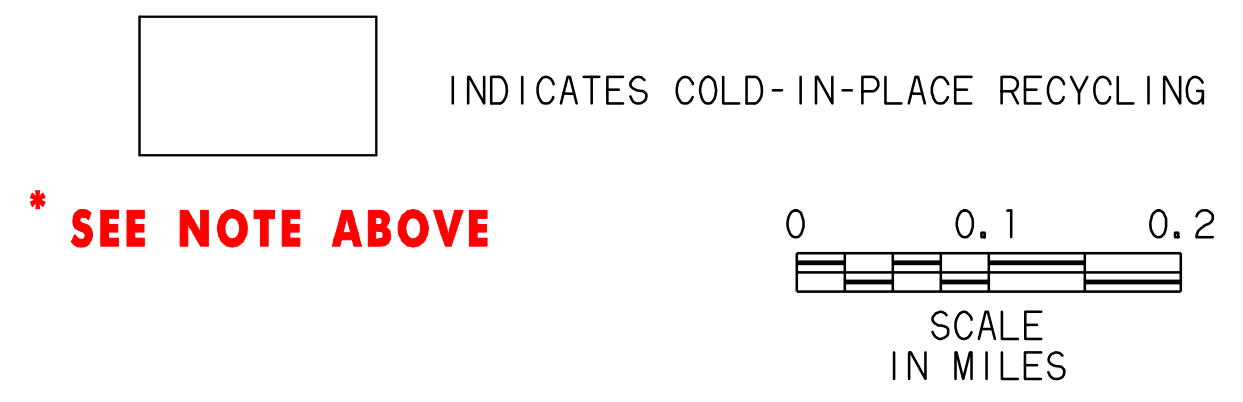

PAVING PROJECT LAYOUT SHEET ONE	
SURVEYED BY	N/A DATE N/A
DRAWN BY	PAVE DATE 1/95
SQUAD LEADER	N/A
DESIGN FILE NO.	/pave/93b080/pb080a.dgn
IPARM FILE	pb080a11.i DATE PLOTTED 23-MAR-2001
PROJ. NAME	DORSET-MT. TABOR-DANBY
PROJ. NO.	NH 9514(1) C/1
SHEET	4 OF 6 SHEETS