

MATCH TO STRIPING DRAWING NO. 7, 411+00

MATCH TO STRIPING DRAWING NO. 9, 417+00

LEGEND

- STREET LIGHT POLE
- UTILITY POLE
- LUMINAIRE
- ⊙ STRAIN POLE W/ MAST ARM
- PEDESTRIAN POLE
- PULL BOX OR JUNCTION BOX
- === SIGNAL CONDUIT
- INTERCONNECT CABLE CONDUIT
- - - LIGHTING CONDUIT
- + + + SIGN MOUNTING POST(S)
- OVERHEAD MOUNTED SIGN

- [PB S-1] = SIGNAL PULLBOX NUMBER
- [JB 1-41] = INTERCONNECT JUNCTION BOX NUMBER
- [JB L-1] = LIGHTING JUNCTION BOX NUMBER
- [PB P-1] = POWER SOURCE PULLBOX NUMBER

- AS-BUILT LEGEND**
- WATER AS-BUILTS
 - SEWER AS-BUILTS
 - DRAINAGE AS-BUILTS
 - ELECTRICAL AS-BUILTS
 - PAVEMENT/OTHER AS-BUILTS

SHELburne - SOUTH BURLINGTON

SURVEYED BY V.S.C. INC. DATE _____
 DRAWN BY E.A.A. INC. DATE _____
 TRACED BY E.A.A. INC. DATE _____

PROJECT NH-EGC-019-4(28)
 SIGN AND STRIPING DRAWING NO. 8
 SHEET NO. 100 OF 283

GENERAL NOTES:

- SEE LIGHTING DRAWINGS NO's. 1 THROUGH 10 FOR LIGHTING CONDUITS, JUNCTION BOXES, WIRING AND SLEEVES.
- SEE LIGHTING DRAWINGS NO's. 1 THROUGH 10 FOR INTERCONNECT CONDUITS, JUNCTION BOXES, WIRING AND SLEEVES
- SEE SIGNAL DRAWINGS NO's. 1 THROUGH 6 FOR SIGNAL CONDUITS, PULLBOXES, WIRING, POLES AND SLEEVES.
- INTERCONNECTING CABLE SHALL BE PLACED IN 2" PVC SCHEDULE 40 CONDUIT
- SEE TYPICAL SECTION DRAWING NO. 5 FOR TYPICAL CONDUIT PLACEMENT DETAIL.


SIGN NOTES:

- THE CONTRACTOR SHALL PROVIDE APPROPRIATE HARDWARE TO TOP MOUNT THE STREET NAME SIGNS, INCIDENTAL TO THE TRAFFIC SIGN ITEMS.
- SIGNS ON THE MAST ARMS SHALL BE MOUNTED WITH BLACK HARDWARE ARE TO MATCH THE MAST ARM AND SHALL BE PAID UNDER ITEM 675.20, TRAFFIC SIGNS, TYPE A.
- ALL SIGNS AND POSTS ARE NEW UNLESS OTHERWISE NOTED.
- CCTA BUS STOP SIGNS TO BE OBTAINED FROM CCTA.

AS-BUILT REVISIONS

NO.	DATE	DESCRIPTION
1.	6/29/06	NOTES ADDED PER ENGINEERS MARK UPS

4/4/03

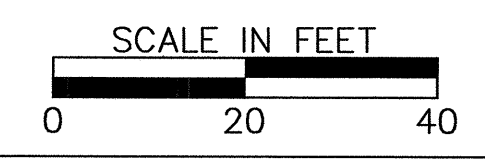

DATUM
 VERTICAL NGVD 1929
 HORIZONTAL NAD 1927