



DEMOLITION & DISPOSAL OF:
 D76 @ 383+05, RT TO 383+40, RT (4 LPS, SIGN & FENCE)
 D77 @ 383+70, LT (SIGN & PLANTER)
 D78 @ 385+05, LT (SIGN & PLANTER)
 D91 @ 380+90, RT (SIGN & PLANTER)
 D92 @ 381+85, RT TO 382+50, RT (LP & FENCE)
 D113 @ 386+45, LT (SIGN & PLANTER)
 D136 @ 383+10, RT (4 PAY PHONES)

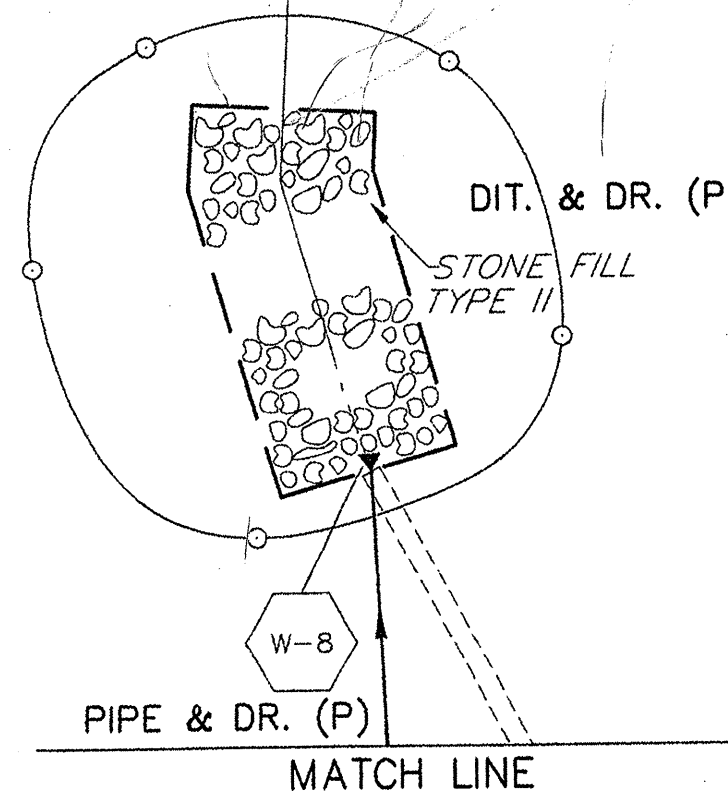

PECOR AUTO SALES, INC., Lessor
333 SHELBURNE CORP., Lessee

NESTI, FRANCES

CHAMP CAR CARE CENTER (WEST), INC.

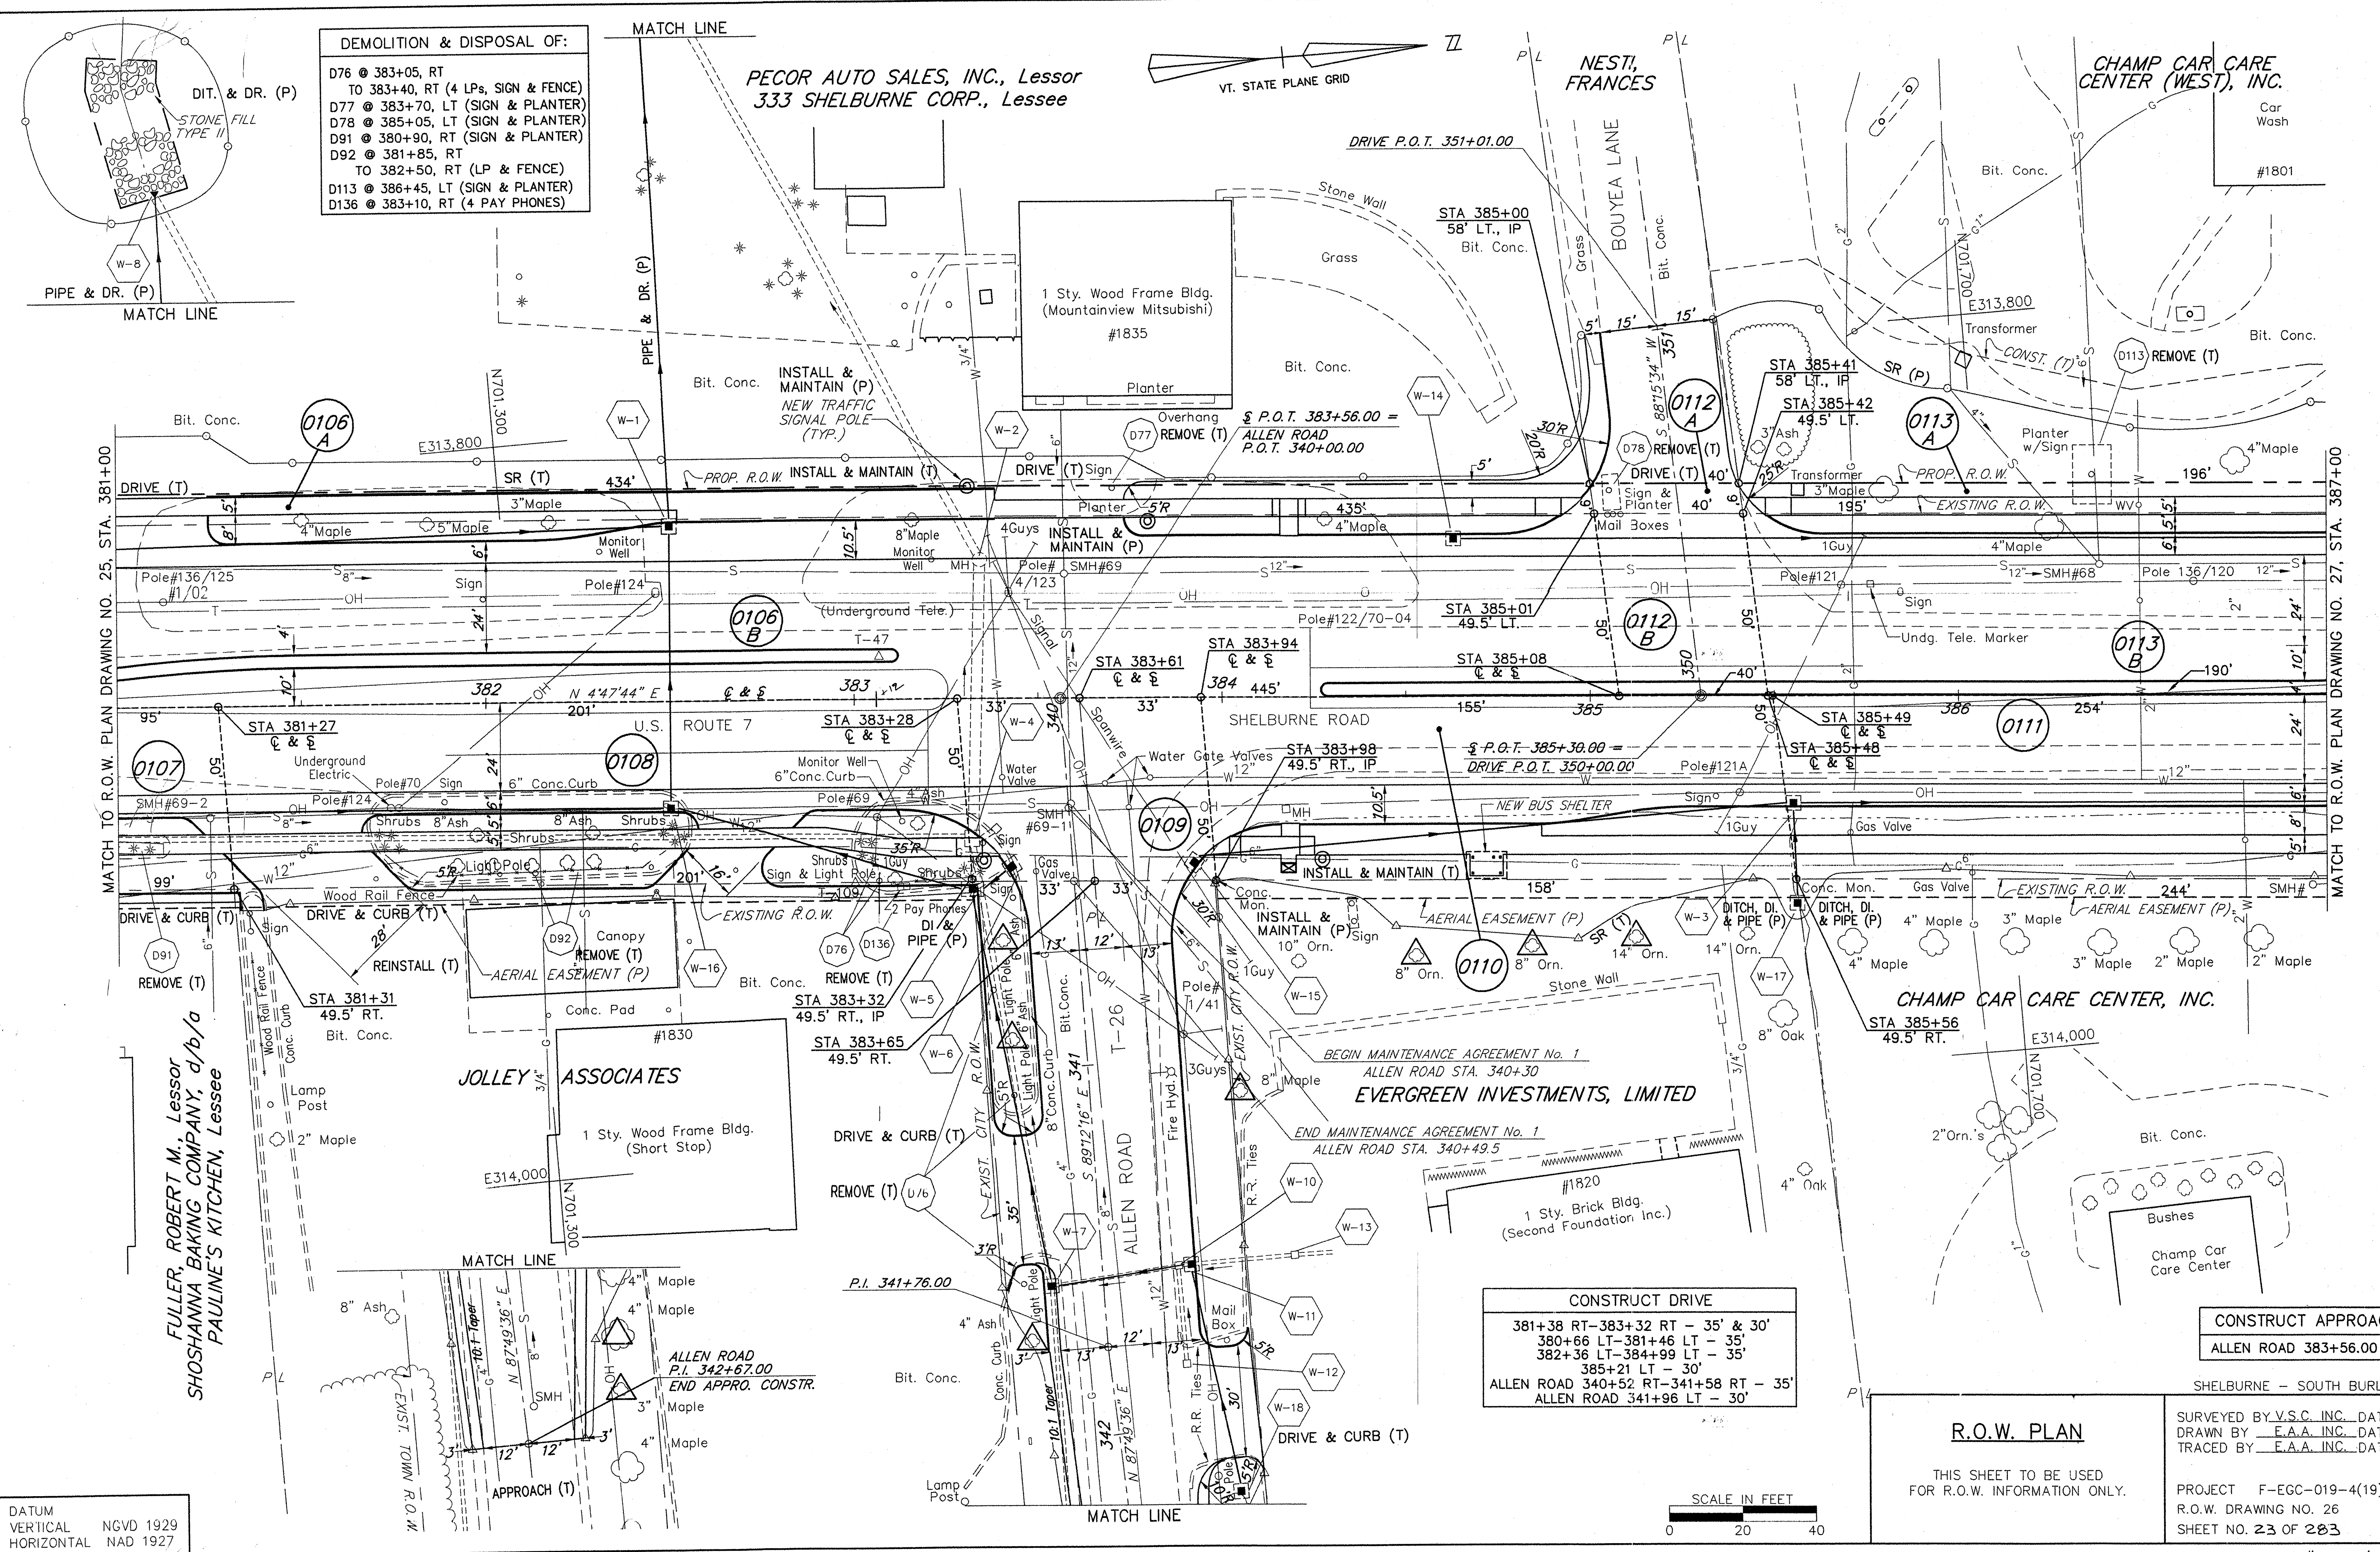

DATUM
 VERTICAL NGVD 1929
 HORIZONTAL NAD 1927

R.O.W. PLAN
 THIS SHEET TO BE USED
 FOR R.O.W. INFORMATION ONLY.

SHELBURNE - SOUTH BURLINGTON

SURVEYED BY V.S.C. INC. DATE _____
 DRAWN BY E.A.A. INC. DATE _____
 TRACED BY E.A.A. INC. DATE _____

PROJECT F-EGC-019-4(19)
 R.O.W. DRAWING NO. 26
 SHEET NO. 23 OF 203