


DATUM
 VERTICAL NGVD 1929
 HORIZONTAL NAD 1927

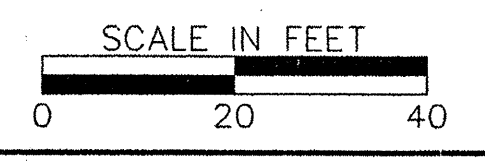

| | |
|---|---|
| R.O.W. PLAN THIS SHEET TO BE USED FOR R.O.W. INFORMATION ONLY. | SURVEYED BY V.S.C. INC. DATE _____ DRAWN BY E.A.A. INC. DATE _____ TRACED BY E.A.A. INC. DATE _____ |
| | PROJECT F-EGC-019-4(19) R.O.W. DRAWING NO. 27 SHEET NO. 24 OF 283 |

C.O.#11, 4/19/02