


DATUM
 VERTICAL NGVD 1929
 HORIZONTAL NAD 1927

CONSTRUCT DRIVE
 417+34 LT - 24'
 418+79 LT - 24'
 420+89 LT - 35'

DEMOLITION & DISPOSAL OF:
 D85 @ 417+95, LT (SIGN & PLANTER)
 D86 @ 419+25, LT (SIGN, LP & LANDSCAPING)
 D98 @ 422+83, RT (ELECTRICAL PANEL)
 D102 @ 419+90, LT (SIGN & 2 GLs)
 D139 @ 421+20, LT (SIGN)

CONSTRUCT APPROACH
 JUGHANDLE H 420+00.00 RT

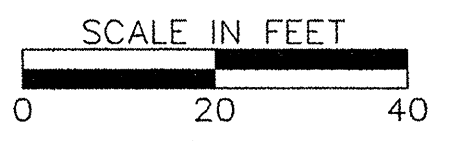

R.O.W. PLAN
 THIS SHEET TO BE USED
 FOR R.O.W. INFORMATION ONLY.

SURVEYED BY V.S.C. INC. DATE _____
 DRAWN BY E.A.A. INC. DATE _____
 TRACED BY E.A.A. INC. DATE _____
 PROJECT F-EGC-019-4(19)
 R.O.W. DRAWING NO. 32
 SHEET NO. 29 OF 283