



DEMOLITION & DISPOSAL OF:
 D87 @ 425+23, LT (SIGN & BOX)
 D88 @ 426+40, LT TO 427+10, LT
 (SIGN, CONC. PAD, PLANTER & 5 LAMP POSTS)

LEWIS, ALEXANDER S.

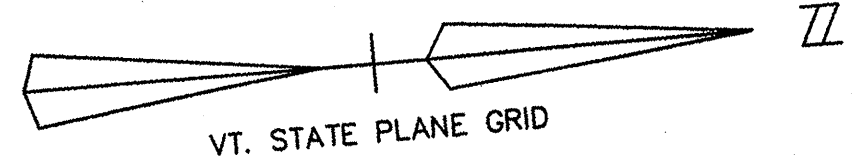

LAKELAND ASSOCIATES
(JOHN C. GLEBK)

CONSTRUCT APPROACH	CONSTRUCT DRIVE
IDX DRIVE 423+81.08 RT HOLMES ROAD 423+88.73 LT IMPERIAL DRIVE 428+36.79 RT JUGHANDLE H 421+31.00 LT	426+76 RT - 36' 426+58 LT - 35' HOLMES RD. 431+61 RT - 35'

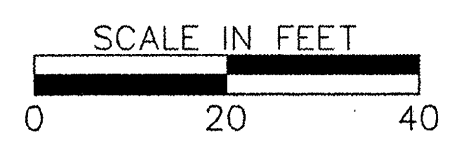

R.O.W. PLAN
 THIS SHEET TO BE USED
 FOR R.O.W. INFORMATION ONLY.

SURVEYED BY V.S.C. INC. DATE _____
 DRAWN BY E.A.A. INC. DATE _____
 TRACED BY E.A.A. INC. DATE _____
 PROJECT F-EGC-019-4(19)
 R.O.W. DRAWING NO. 33
 SHEET NO. 30 OF 203

DATUM
 VERTICAL NGVD 1929
 HORIZONTAL NAD 1927