


**NOTES:**  
 1. UNDERGROUND UTILITY LOCATIONS ARE PLOTTED BASED ON THE BEST AVAILABLE INFORMATION. LOCATIONS SHOULD BE VERIFIED BY THE CONTRACTOR BEFORE WORK.  
 2. SEE PLAN NOTES DRAWING NO. 1 FOR PLAN NOTES AND GENERAL NOTES.

LEWIS, ALEXANDER S.

**CONSTRUCT APPROACH**  
 HOLMES ROAD EXT. 423+81.08 RT  
 HOLMES ROAD 423+88.73 LT  
 IMPERIAL DRIVE 428+36.79 RT  
 JUGHANDLE H 421+31.00 LT

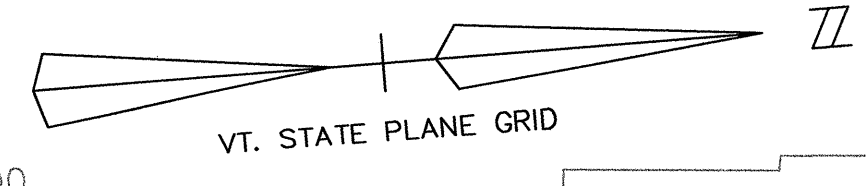

MATCH TO PLAN DRAWING NO. 9, STA. 423+00

LAKEWOOD ASSOCIATES  
(JOHN C. GIEBINK)

**CONSTRUCT DRIVE**  
 426+76 RT - 36'  
 426+58 LT - 35'  
 HOLMES RD. 431+61 RT - 35'

**PORTLAND CEMENT CONCRETE SIDEWALK - 5"**  
 (MEDIAN WIDTH 4-6 FT.)  
 423+00 TO 423+15

**PORTLAND CEMENT CONCRETE SIDEWALK - 5"**  
 (MEDIAN WIDTH 4-6 FT.)  
 423+00 TO 423+15

**PORTLAND CEMENT CONCRETE SIDEWALK - 5"**  
 (MEDIAN WIDTH 4-6 FT.)  
 423+00 TO 423+15

**AS-BUILT LEGEND**

—	WATER AS-BUILTS
—	SEWER AS-BUILTS
—	DRAINAGE AS-BUILTS
—	ELECTRICAL AS-BUILTS
—	PAVEMENT / OTHER AS-BUILTS

**CONSTRUCT SIDEWALK RAMP**

TYPE	
1	423+34, LT
1	423+59, RT
1	424+14, RT
1	424+13, LT
1	428+09, RT
1	424+31, LT
2	424+31, RT

**DEMOLITION & DISPOSAL OF:**  
 D87 @ 425+23, LT (SIGN & BOX)  
 D88 @ 426+40, LT TO 427+10, LT  
 (SIGN\*, CONC. PAD\*, PLANTER\* & 5 LAMP POSTS\*)  
 \* - REMOVED BY OTHERS AS OF JAN. 2003

**AS-BUILT REVISIONS**

NO.	DATE	DESCRIPTION
1.	3/3/06	SEWER, DRAINAGE & ELEC. EDITS

**PORTLAND CEMENT CONCRETE SIDEWALK - 8"**  
 426+50 - 427+00 RT  
 426+72 - 427+21 LT


**PORTLAND CEMENT CONCRETE SIDEWALK - 5"**  
 423+00 - 423+59 RT  
 424+10 - 426+50 RT  
 427+00 - 428+12 RT  
 423+00 - 423+37 LT  
 424+10 - 426+72 LT  
 427+21 - 428+95 LT

**SHELburne - SOUTH BURLINGTON**  
 SURVEYED BY V.S.C. INC. DATE \_\_\_\_\_  
 DRAWN BY E.A.A. INC. DATE \_\_\_\_\_  
 TRACED BY E.A.A. INC. DATE \_\_\_\_\_

PROJECT F-EGG-019-4(19)  
 PLAN DRAWING NO. 10  
 SHEET NO. 78 OF 283

DATUM  
 VERTICAL NGVD 1929  
 HORIZONTAL NAD 1927

FOR PROFILE SEE PROFILE DRAWING NO. 10

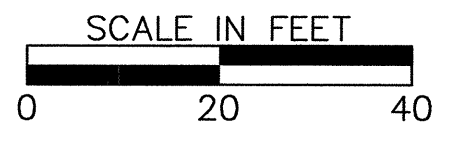

K:\EGG\019\US Res 7 Shelburne Rd\AS-BUILT\WATER-SEWER\AS-BUILT PL-32\_4\_10.DWG, Layout1, 9/12/2006 1:28:00 PM, parmeta, W:\d\40\VT-BRU-HP1056m.dwg