


PLAN

DATE	
BY	
SAVED	
ALIGNED	
RT. OF WAY CHECKED	
NOTE BOOK NO.	


PROFILE

DATE	
BY	
SAVED	
ALIGNED	
RT. OF WAY CHECKED	
NOTE BOOK NO.	

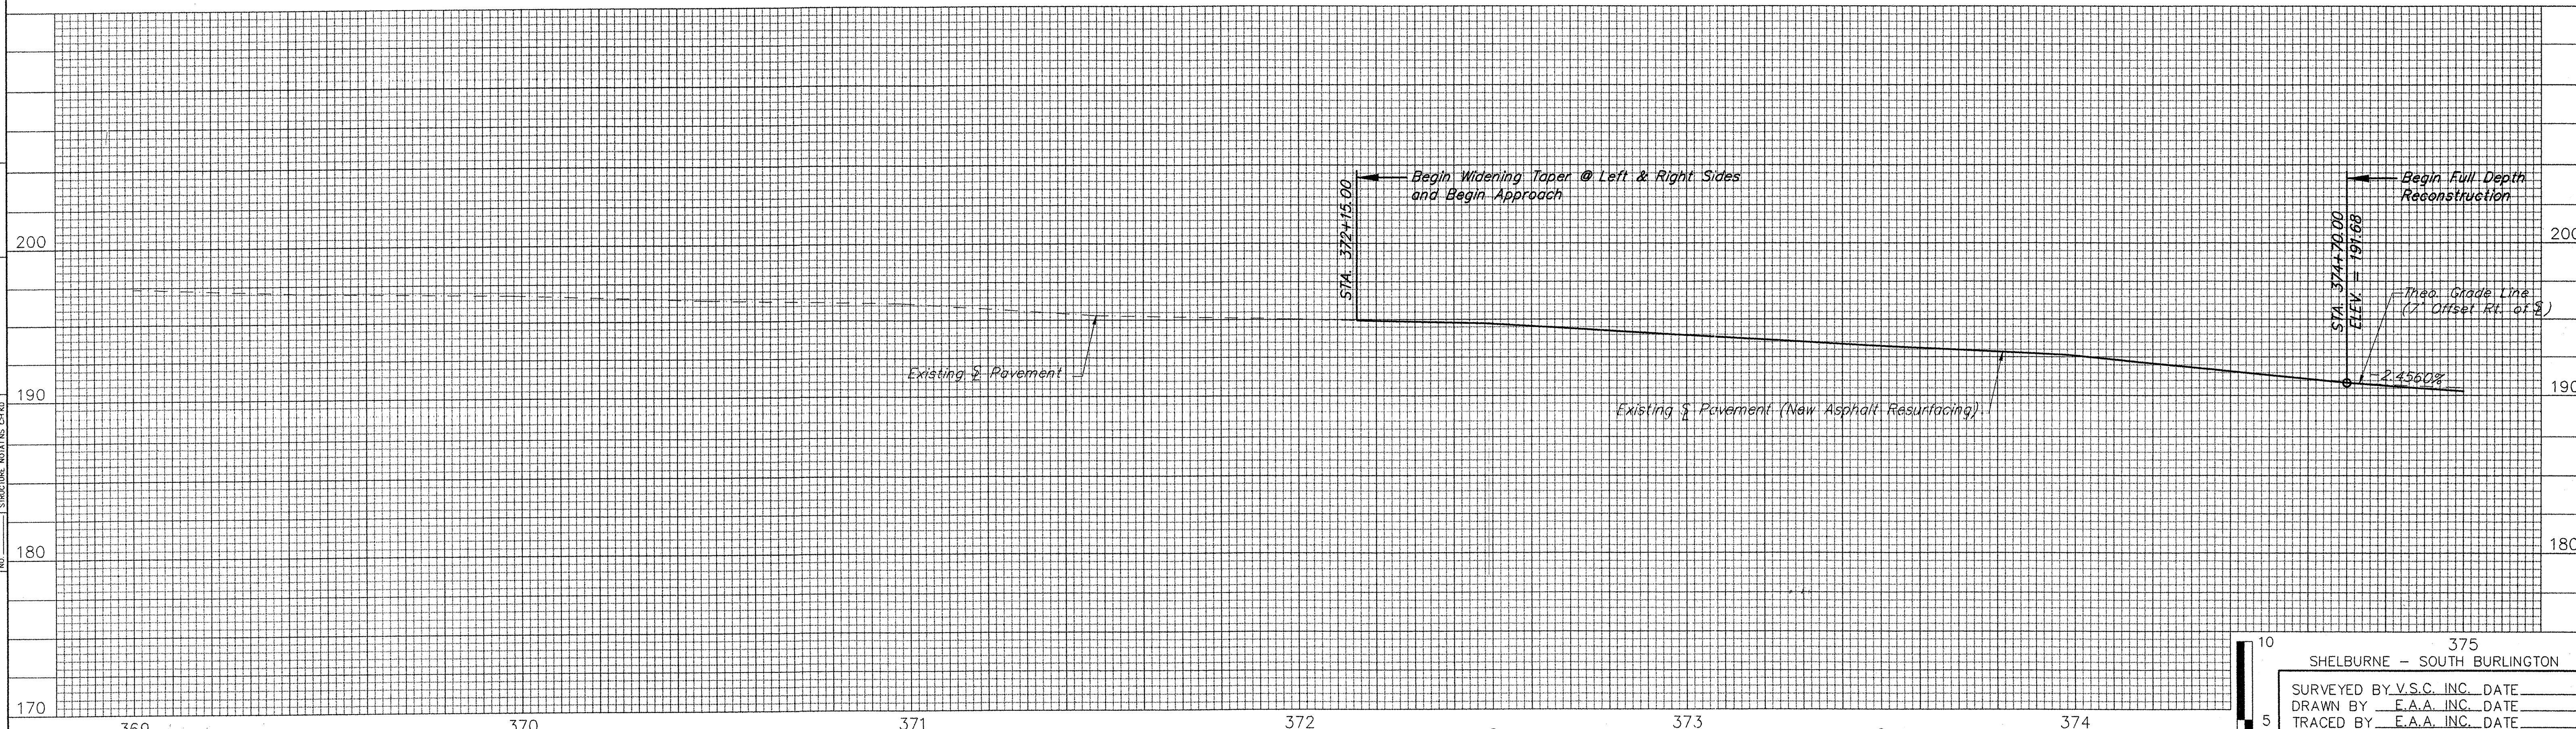

DATUM
 VERTICAL NGVD 1929
 HORIZONTAL NAD 1927

4/4/03 FOR PLAN SEE PLAN DRAWING NO. 1

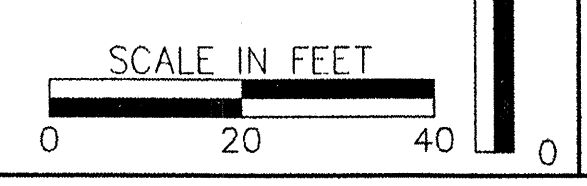

375
 SHELburne - SOUTH BURLINGTON

SURVEYED BY V.S.C. INC. DATE _____
 DRAWN BY E.A.A. INC. DATE _____
 TRACED BY E.A.A. INC. DATE _____

PROJECT NH-EGC-019-4(28)
 PROFILE DRAWING NO. 1
 SHEET NO. 80 OF 283