



DATE \_\_\_\_\_  
 BY \_\_\_\_\_  
 PLAN  
 SURVEYED \_\_\_\_\_  
 GRADES CHECKED \_\_\_\_\_  
 NOTE BOOK NO. \_\_\_\_\_  
 RT. OF WAY CHECKED \_\_\_\_\_

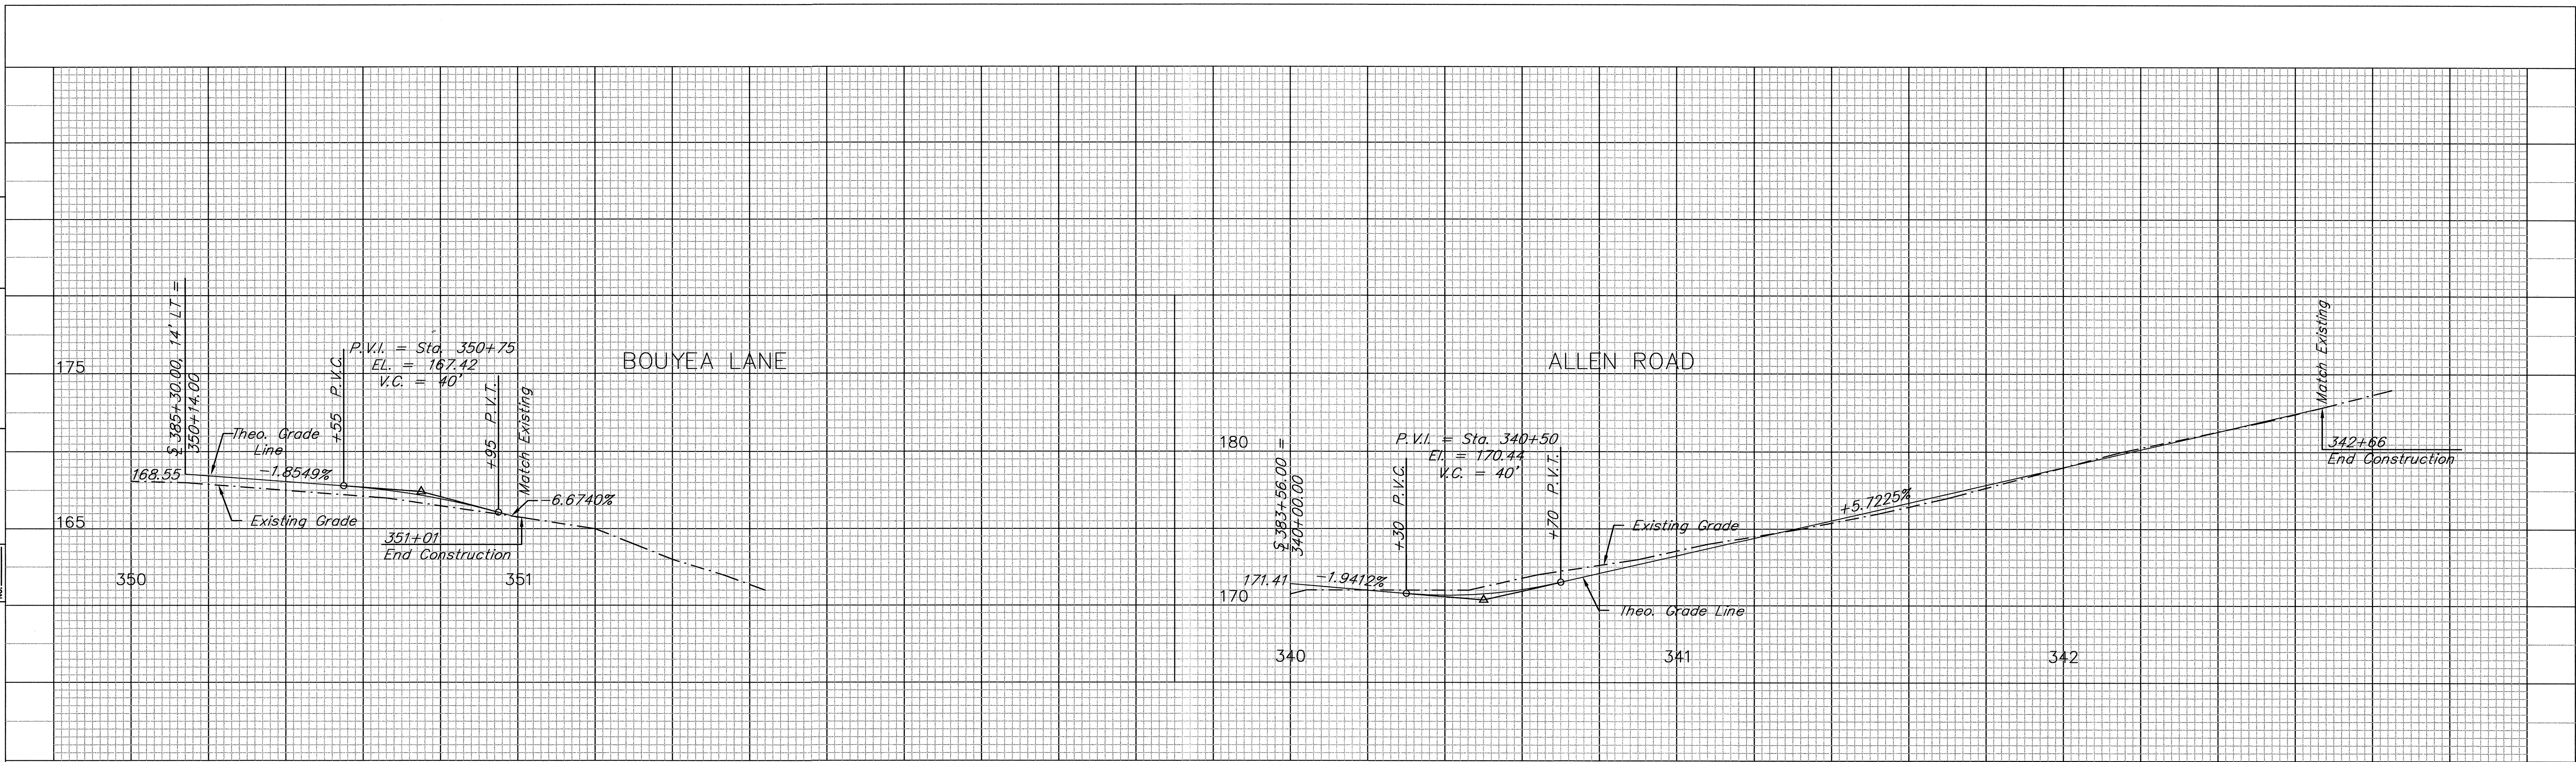

DATE \_\_\_\_\_  
 BY \_\_\_\_\_  
 PROFILE  
 SURVEYED \_\_\_\_\_  
 GRADES CHECKED \_\_\_\_\_  
 NOTE BOOK NO. \_\_\_\_\_  
 STRUCTURE NOTATIONS CHVD \_\_\_\_\_

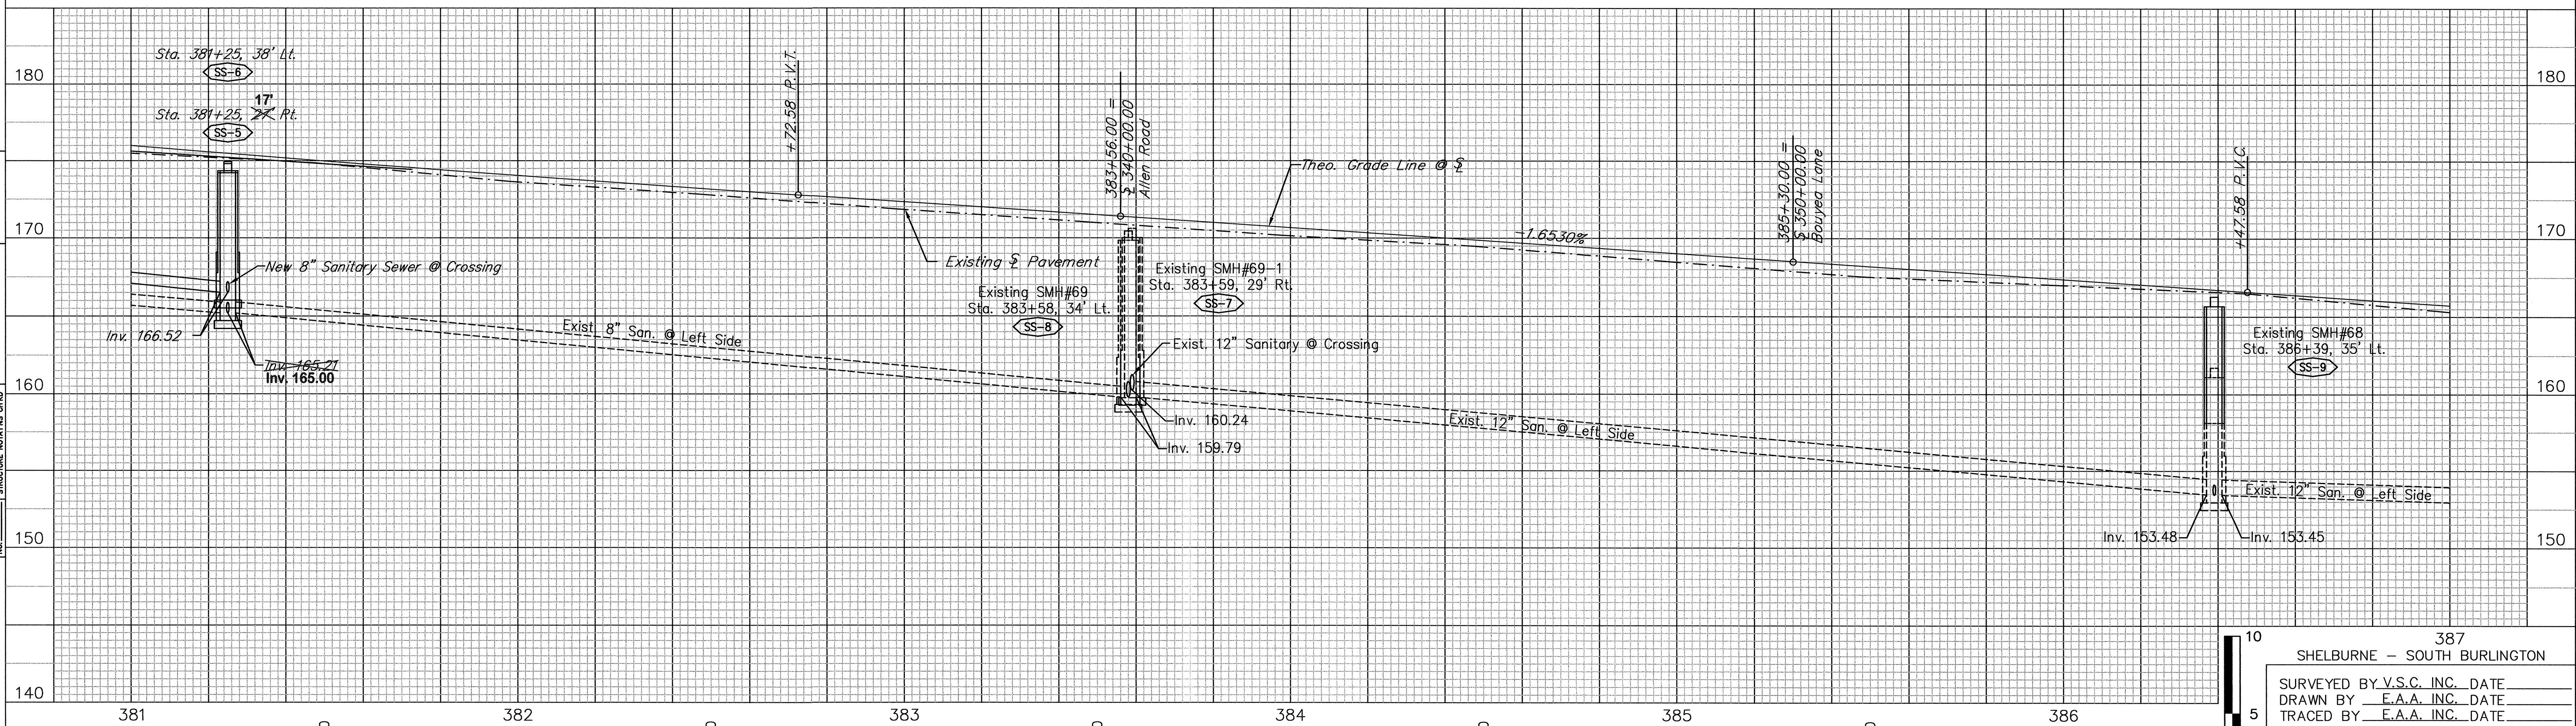


DATUM  
 VERTICAL NGVD 1929  
 HORIZONTAL NAD 1927

**AS-BUILT REVISIONS**

NO.	DATE	DESCRIPTION
1.	3/2/06	SEWER EDITS
2.	8/8/06	SEWER TEXT EDITS

FOR PLAN SEE PLAN DRAWING NO. 3

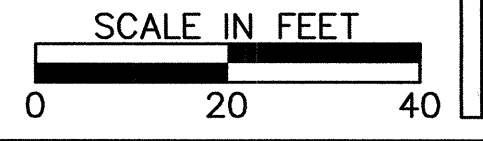

387  
 SHELBURNE - SOUTH BURLINGTON  
 SURVEYED BY V.S.C. INC. DATE \_\_\_\_\_  
 DRAWN BY E.A.A. INC. DATE \_\_\_\_\_  
 TRACED BY E.A.A. INC. DATE \_\_\_\_\_  
 PROJECT NH-EGC-019-4(28)  
 PROFILE DRAWING NO. 3  
 SHEET NO. 82 OF 283