
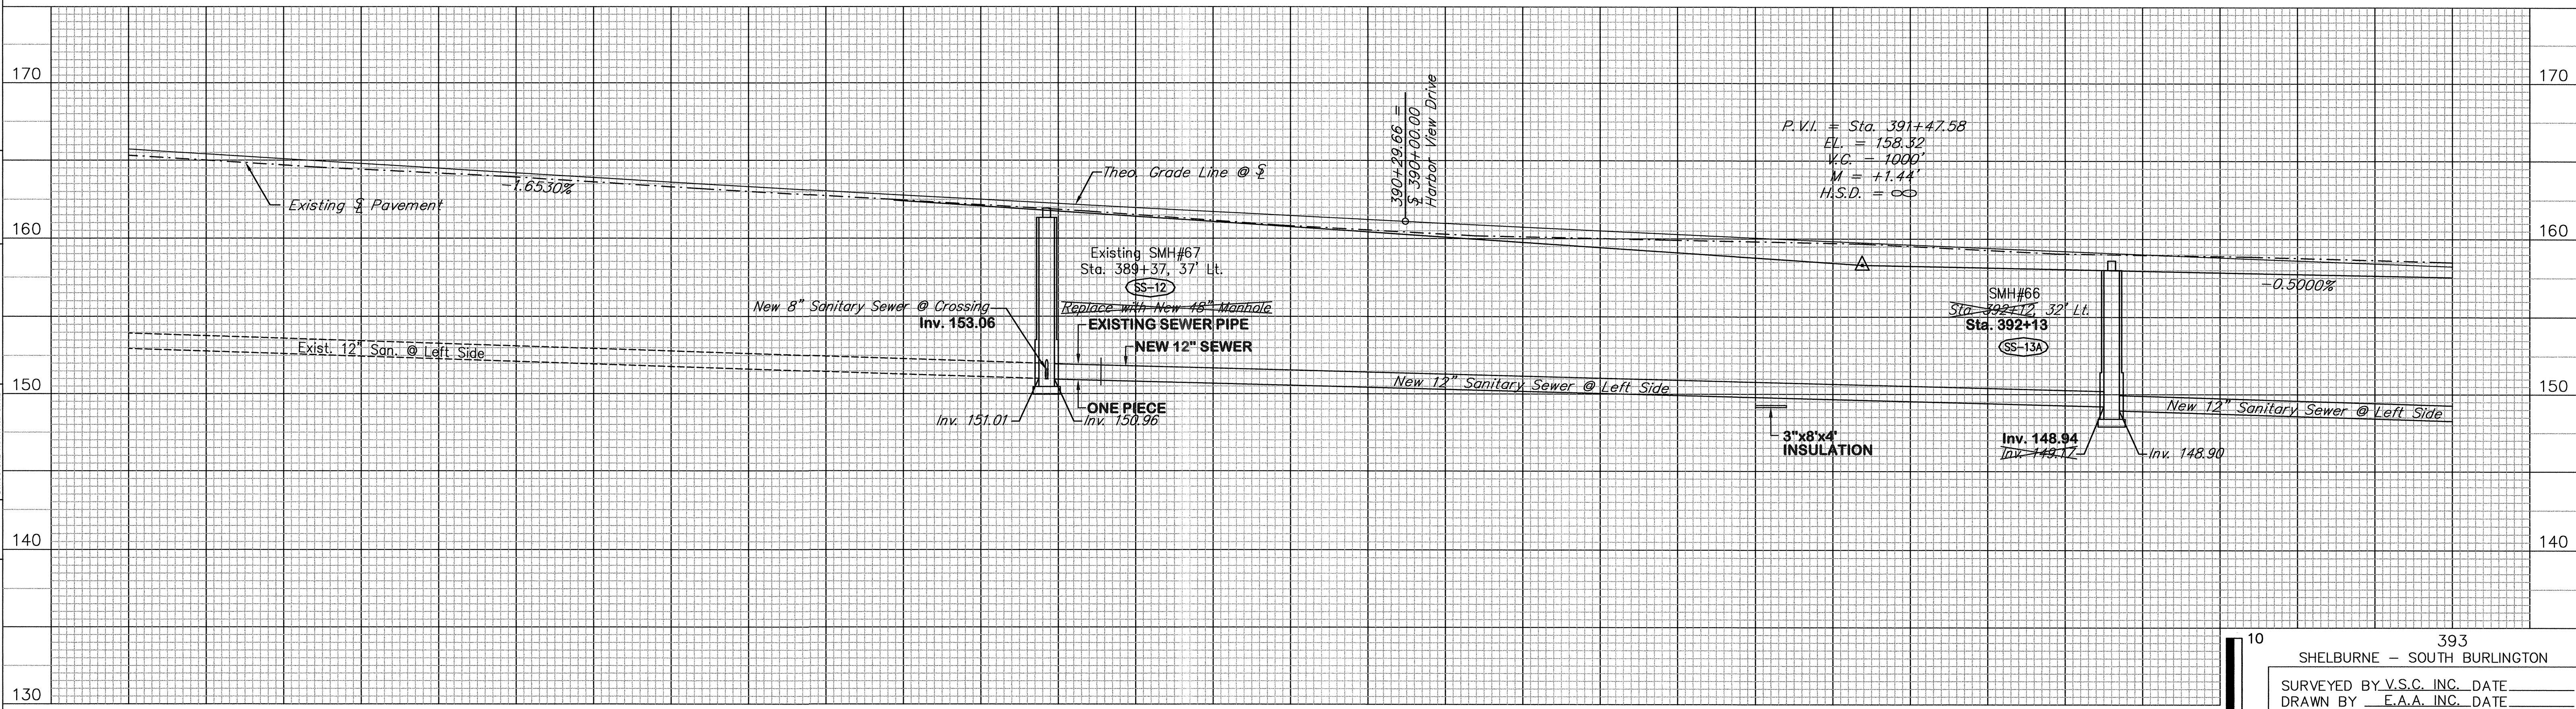


DATE _____
 BY _____
 SURVEYED _____
 PLANNED _____
 PLOTTED _____
 REVISIONS CHECKED _____
 REVISIONS DATE _____
 REVISIONS BY _____
 NOTE BOOK NO. _____

DATE _____
 BY _____
 SURVEYED _____
 PLANNED _____
 PLOTTED _____
 REVISIONS CHECKED _____
 REVISIONS DATE _____
 REVISIONS BY _____
 NOTE BOOK NO. _____

DATUM
 VERTICAL NGVD 1929
 HORIZONTAL NAD 1927

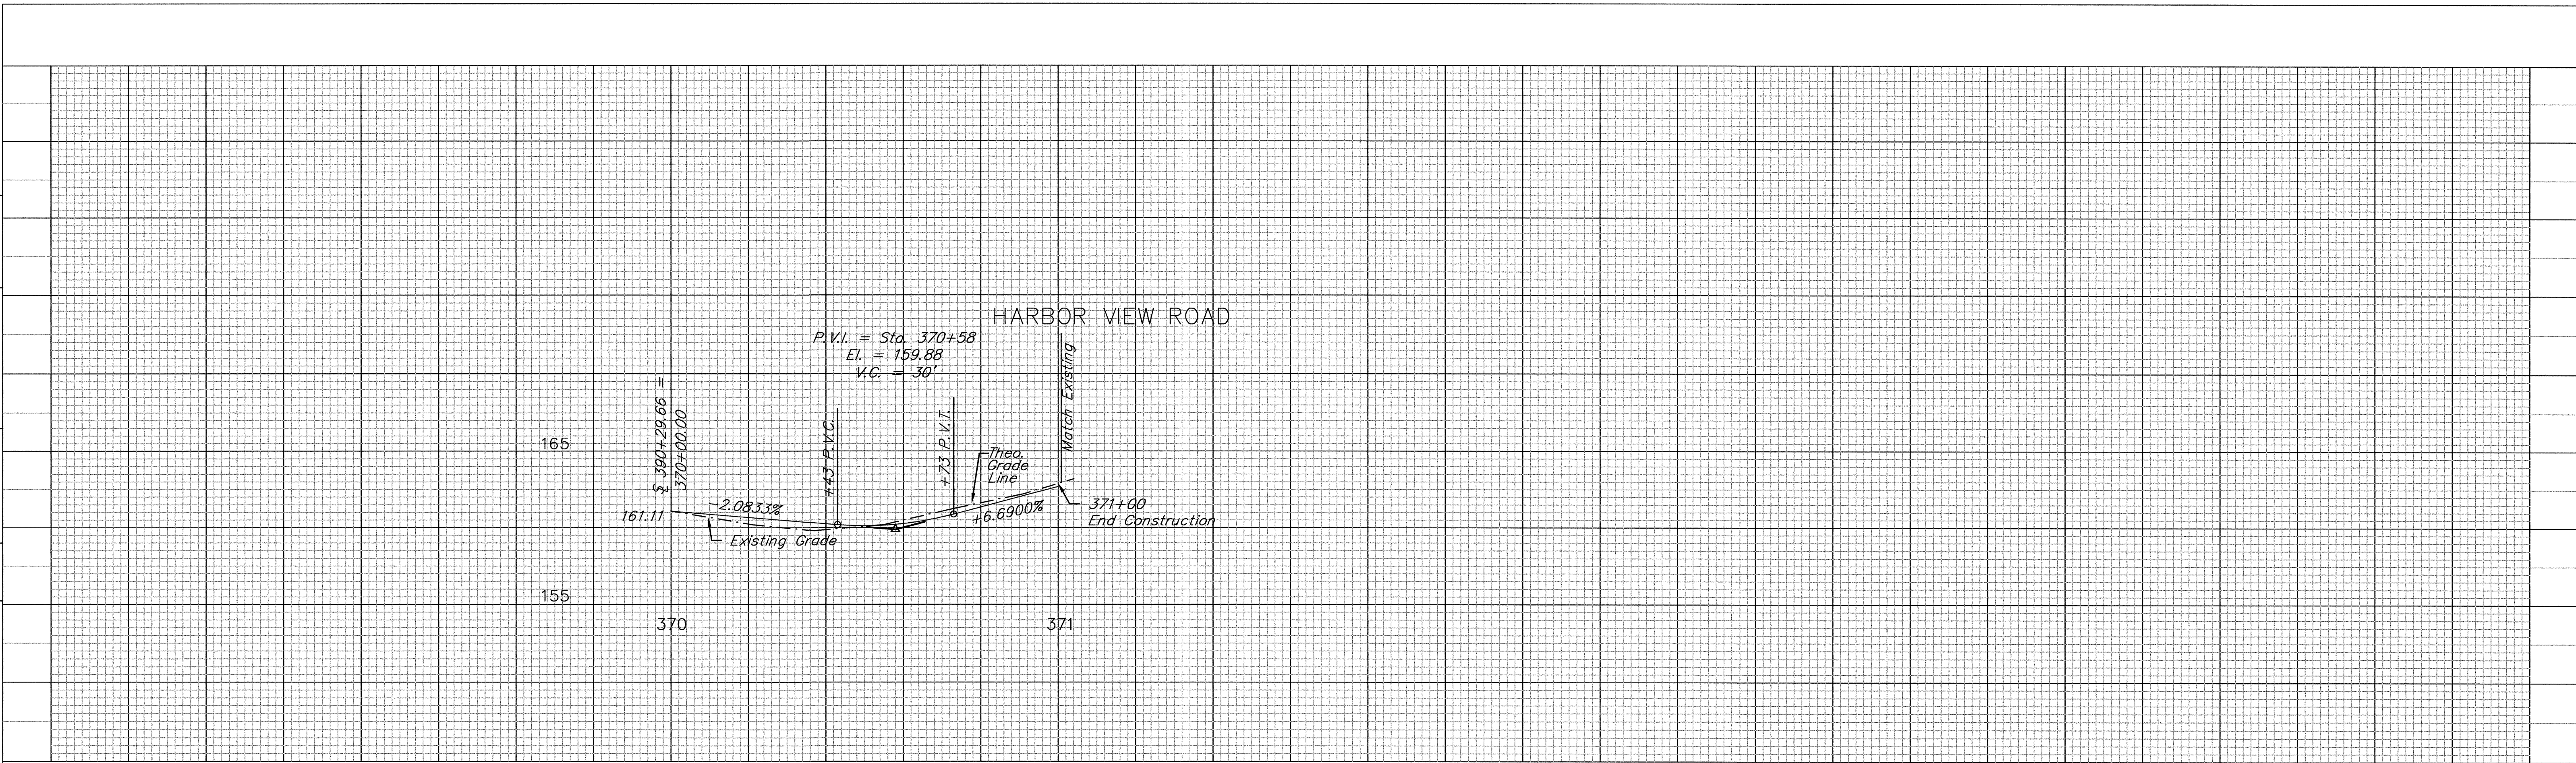

DATUM
 VERTICAL NGVD 1929
 HORIZONTAL NAD 1927

AS-BUILT REVISIONS		
NO.	DATE	DESCRIPTION
1.	3/2/06	SEWER EDITS

FOR PLAN SEE PLAN DRAWING NO. 4

REVISSED SEWER DESIGN
 SCALE IN FEET
 0 20 40

10
 5
 0

393
 SHELBURNE - SOUTH BURLINGTON

SURVEYED BY V.S.C. INC. DATE _____
 DRAWN BY E.A.A. INC. DATE _____
 TRACED BY E.A.A. INC. DATE _____

PROJECT NH-EGC-019-4(28)
 PROFILE DRAWING NO. 4
 SHEET NO. 83R OF 283