


DATE	
BY	
PLAN	
NOTE BOOK	
NO.	
NO.	

DATE	
BY	
PROFILE	
NOTE BOOK	
NO.	
NO.	

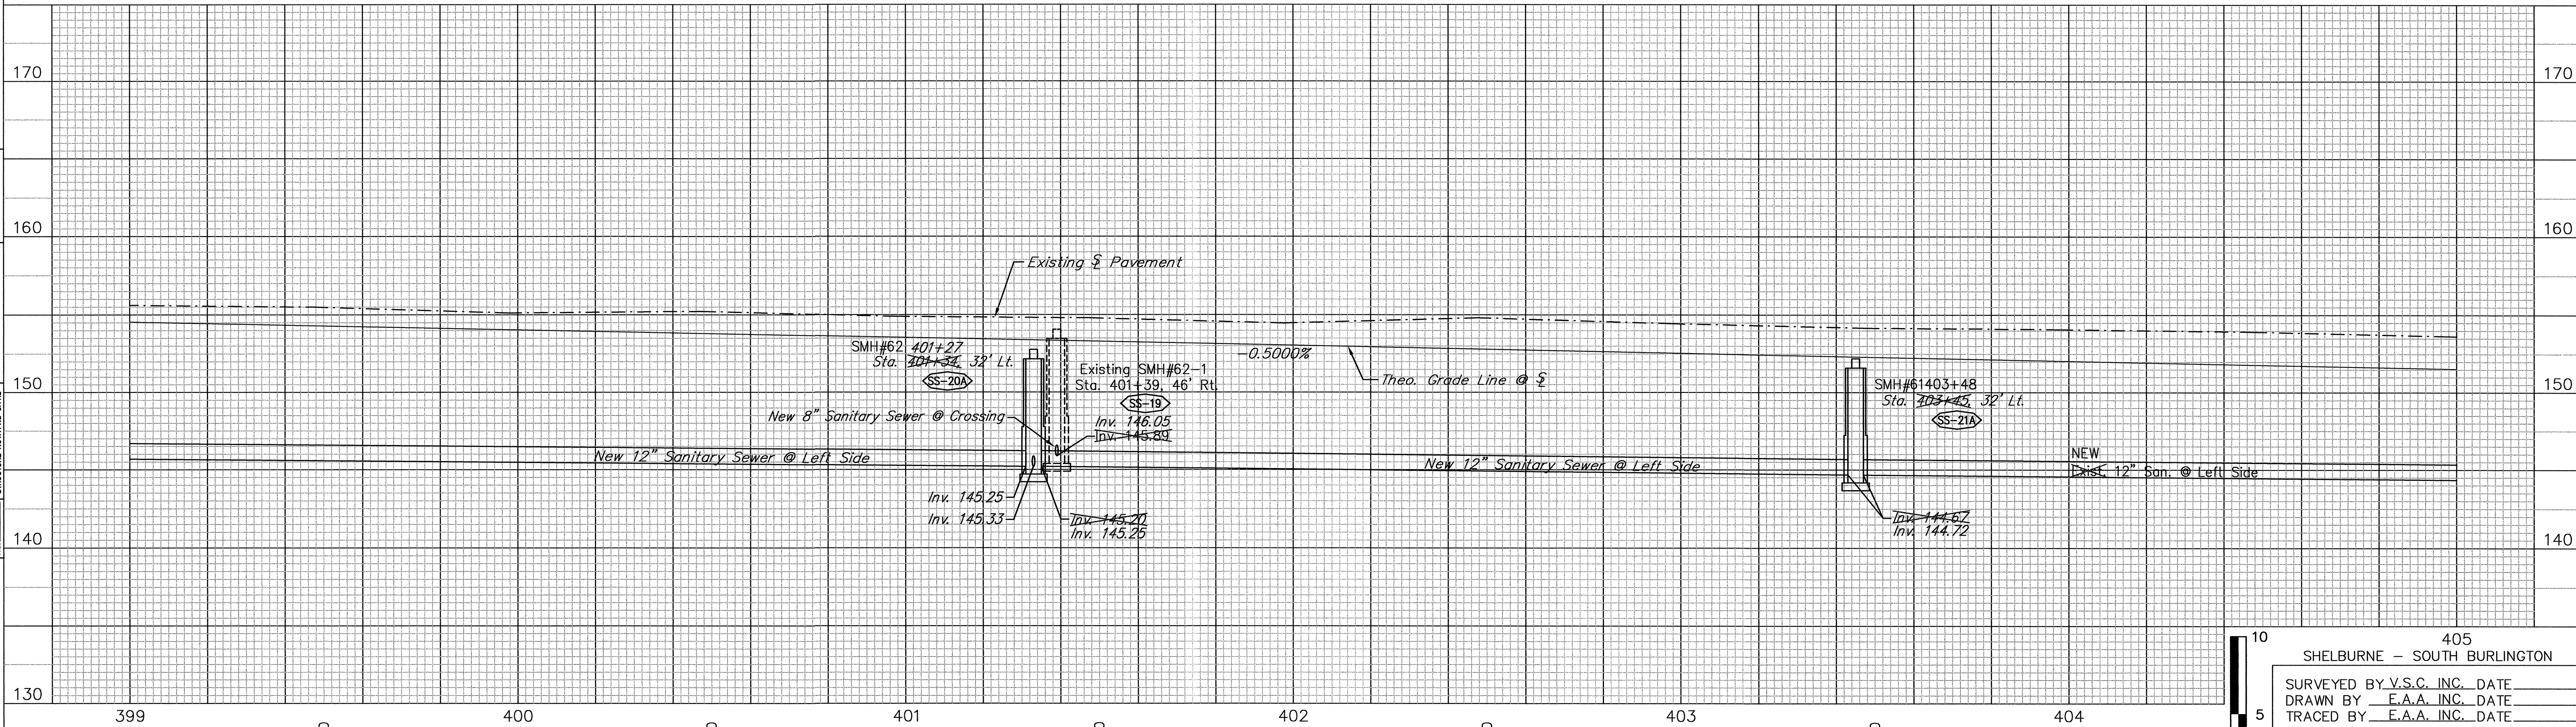

DATUM  
 VERTICAL NGVD 1929  
 HORIZONTAL NAD 1927

AS-BUILT REVISIONS		
NO.	DATE	DESCRIPTION
1.	3/2/06	SEWER EDITS

FOR PLAN SEE PLAN DRAWING NO. 6

REVISSED SEWER DESIGN  
 SCALE IN FEET  
 0 20 40

405  
 SHELburne - SOUTH BURLINGTON  
 SURVEYED BY V.S.C. INC. DATE \_\_\_\_\_  
 DRAWN BY E.A.A. INC. DATE \_\_\_\_\_  
 TRACED BY E.A.A. INC. DATE \_\_\_\_\_  
 PROJECT NH-EGC-019-4(28)  
 PROFILE DRAWING NO. 6  
 SHEET NO. 85R OF 283