



DATE \_\_\_\_\_  
 BY \_\_\_\_\_  
 SURVEYED \_\_\_\_\_  
 PLANNED \_\_\_\_\_  
 DRAWN \_\_\_\_\_  
 CHECKED \_\_\_\_\_  
 DATE \_\_\_\_\_  
 BY \_\_\_\_\_  
 SURVEYED \_\_\_\_\_  
 PLANNED \_\_\_\_\_  
 DRAWN \_\_\_\_\_  
 CHECKED \_\_\_\_\_

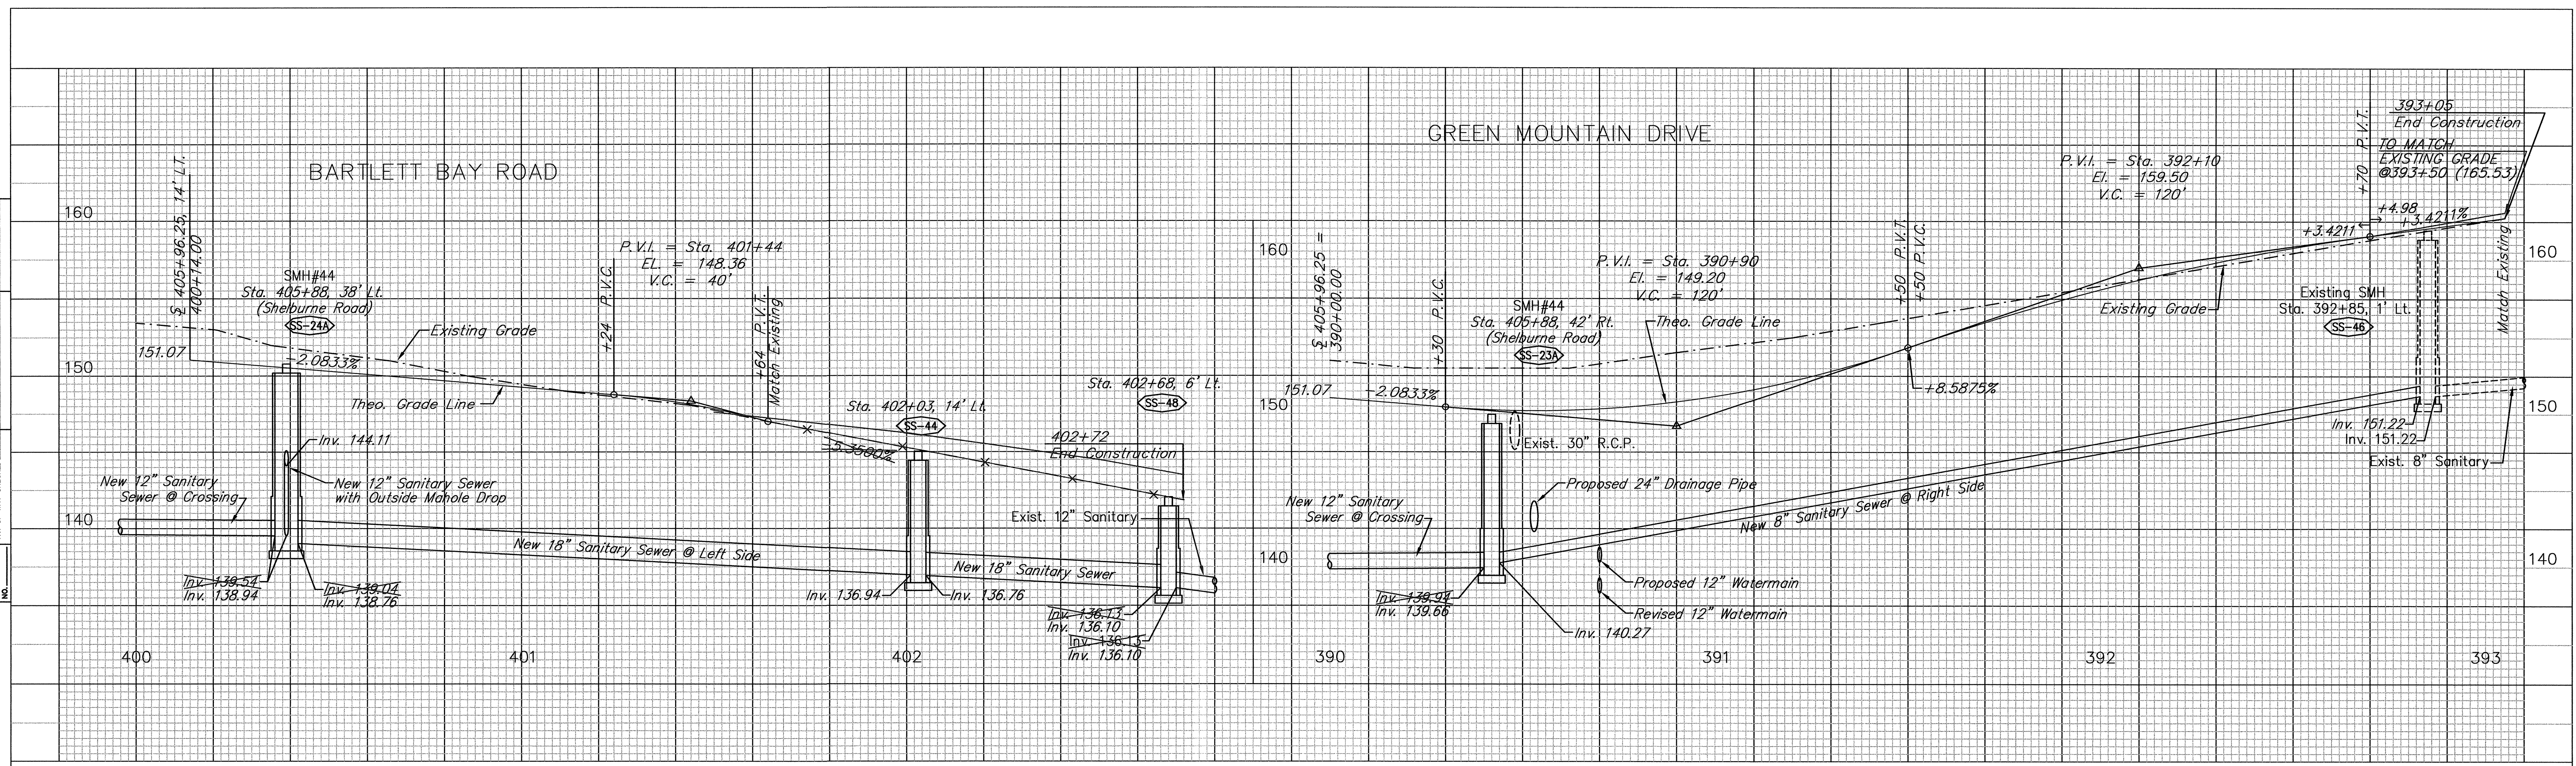

DATE \_\_\_\_\_  
 BY \_\_\_\_\_  
 SURVEYED \_\_\_\_\_  
 PLANNED \_\_\_\_\_  
 DRAWN \_\_\_\_\_  
 CHECKED \_\_\_\_\_

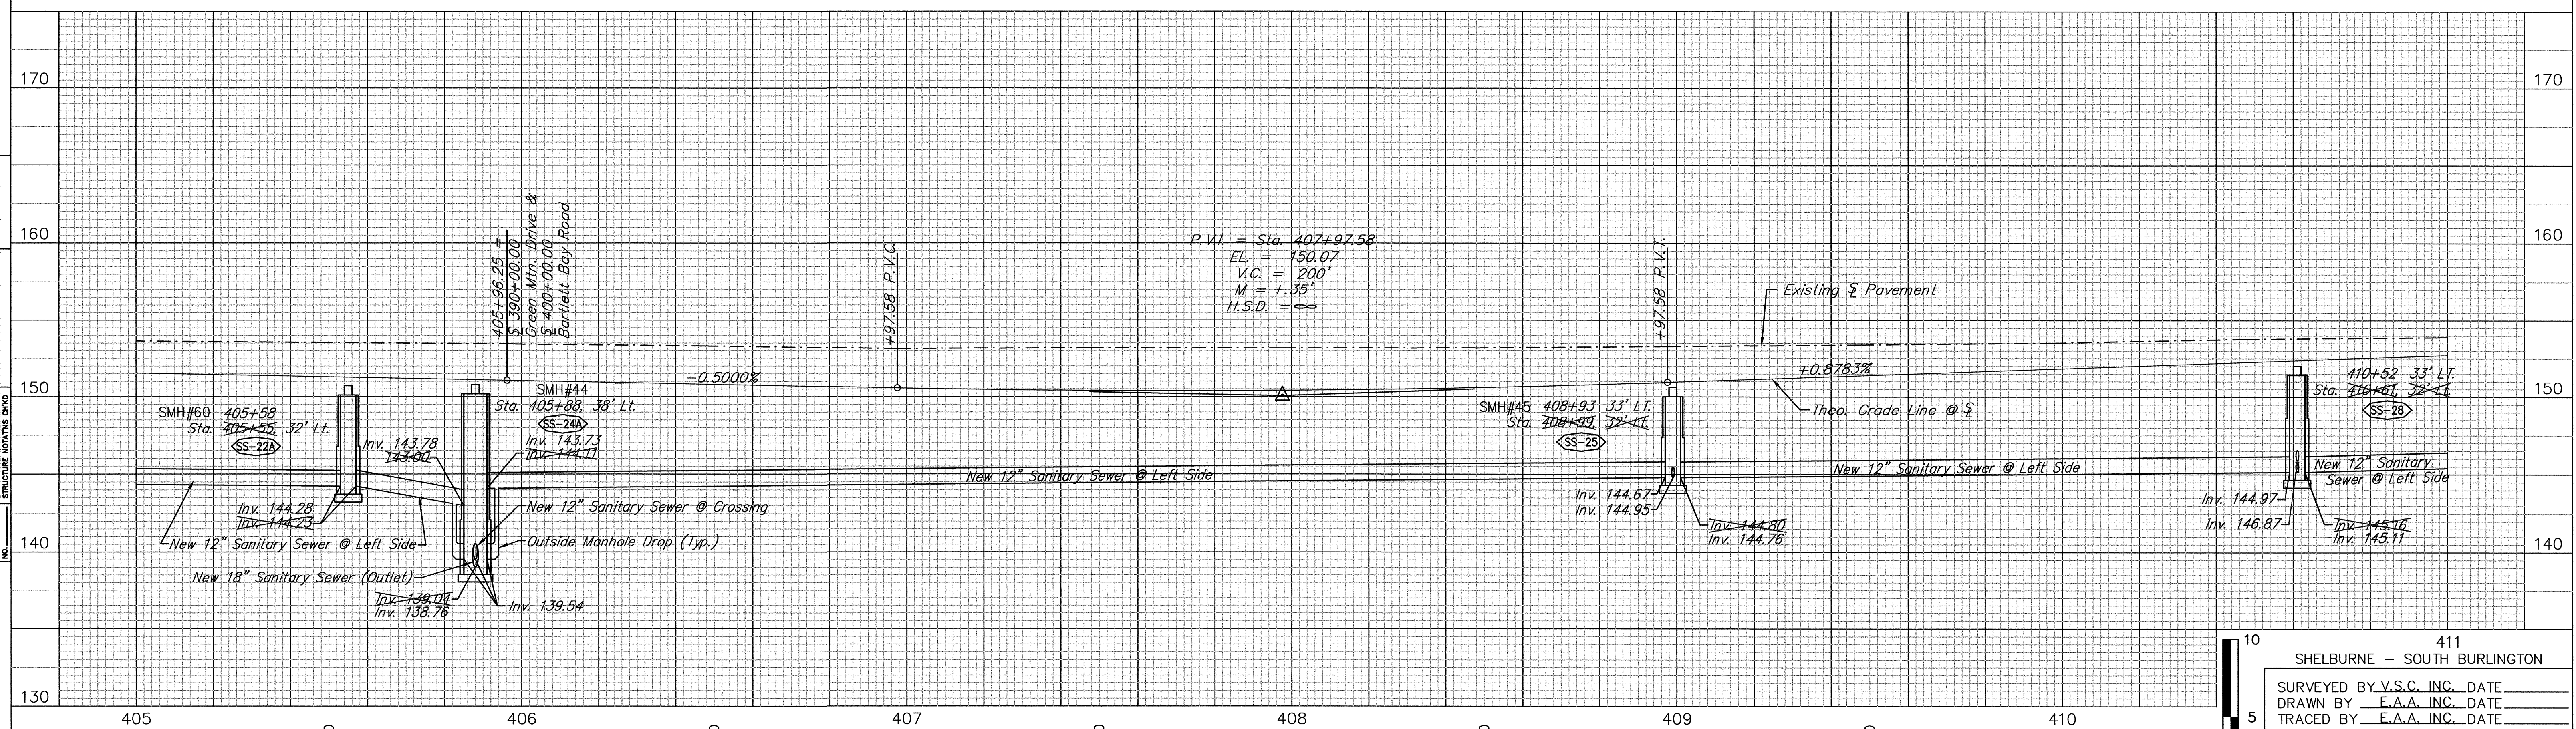

DATUM  
 VERTICAL NCVD 1929  
 HORIZONTAL NAD 1927

NO.	DATE	DESCRIPTION
1.	3/2/06	SEWER EDITS

REVISSED SEWER DESIGN  
 SCALE IN FEET  
 0 20 40

411  
 SHELBURNE - SOUTH BURLINGTON  
 SURVEYED BY V.S.C. INC. DATE \_\_\_\_\_  
 DRAWN BY E.A.A. INC. DATE \_\_\_\_\_  
 TRACED BY E.A.A. INC. DATE \_\_\_\_\_  
 PROJECT NH-ECC-019-4(28)  
 PROFILE DRAWING NO. 7  
 SHEET NO. 86R OF 283

FOR PLAN SEE PLAN DRAWING NO. 7 & 11