


DATE
BY
REVISIONS
NO. DATE DESCRIPTION


DATE
BY
REVISIONS
NO. DATE DESCRIPTION

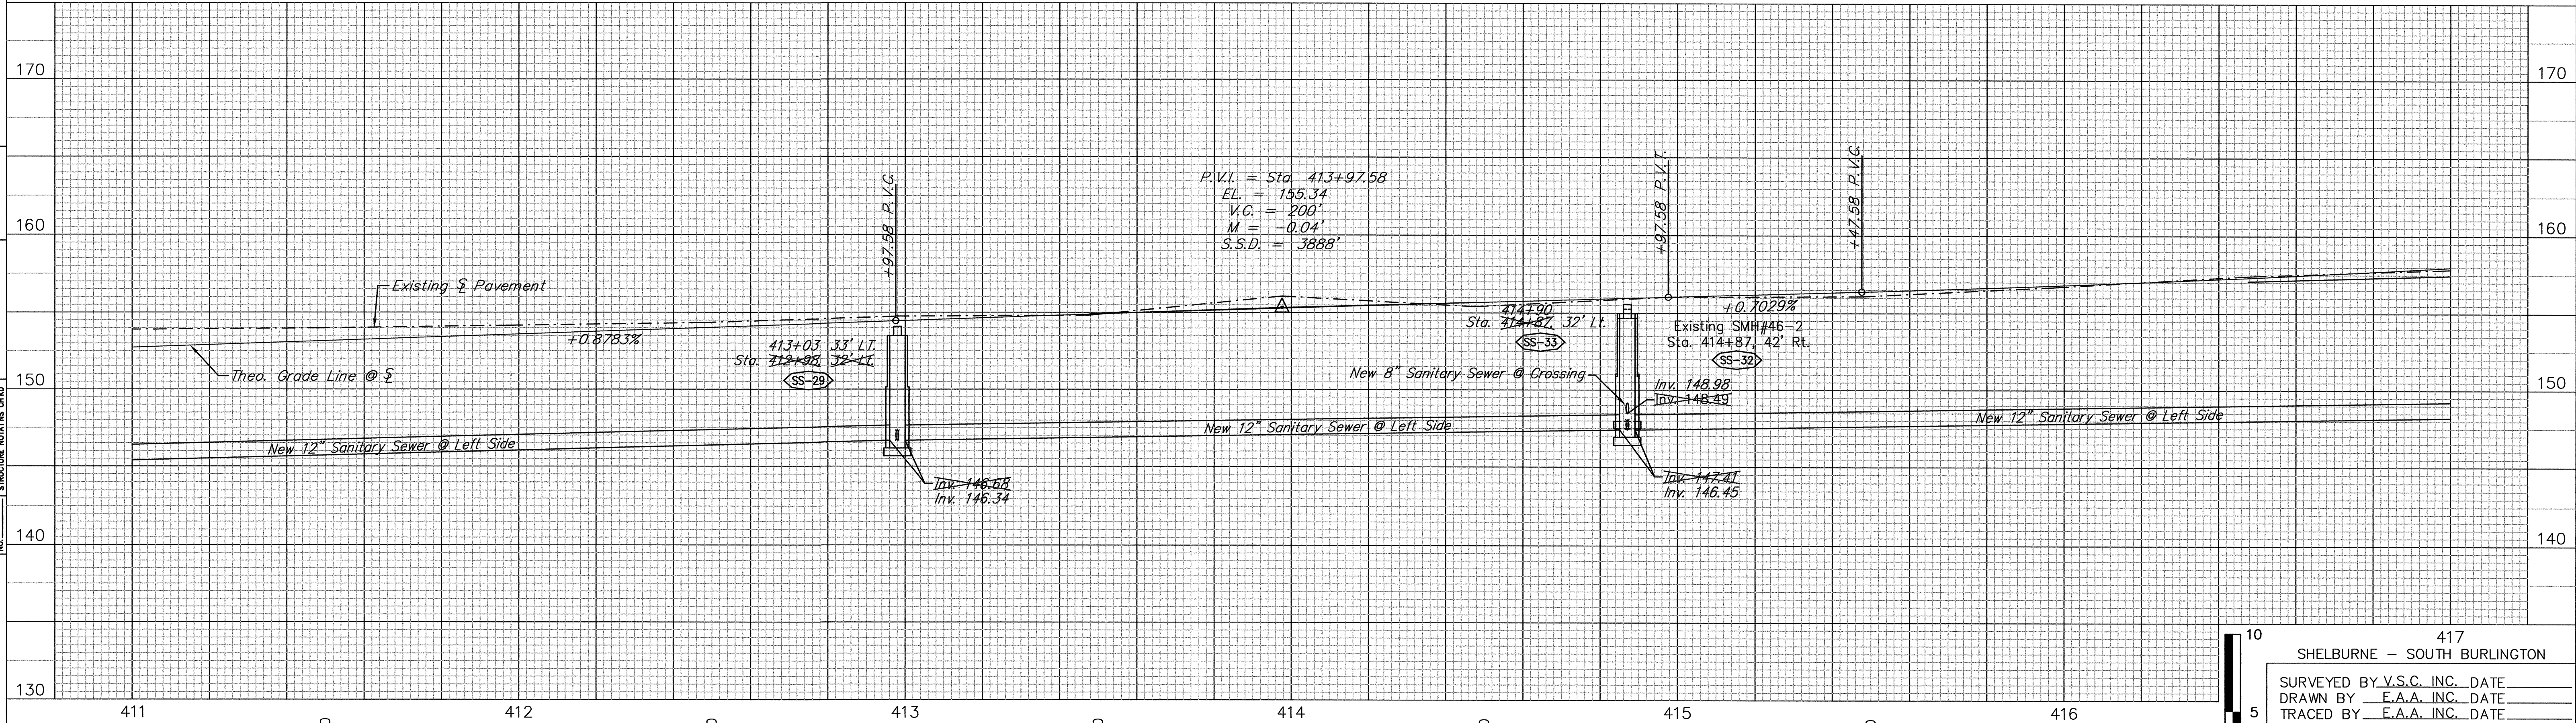

DATUM
VERTICAL NGVD 1929
HORIZONTAL NAD 1927

AS-BUILT REVISIONS		
NO.	DATE	DESCRIPTION
1.	3/2/06	SEWER EDITS

FOR PLAN SEE PLAN DRAWING NO. 8

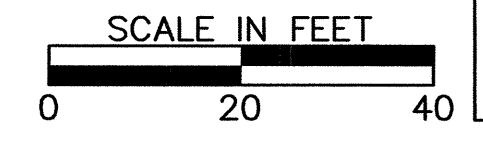

417
SHELburne - SOUTH BURLINGTON

SURVEYED BY V.S.C. INC. DATE _____
 DRAWN BY E.A.A. INC. DATE _____
 TRACED BY E.A.A. INC. DATE _____

PROJECT NH-EGC-019-4(28)
 PROFILE DRAWING NO. 8
 SHEET NO. 87 OF 283