


- NOTES:
1. ALL SIGNS TO BE REMOVED UNLESS OTHERWISE NOTED.
 2. SIGN INVENTORY AS OF NOVEMBER 2002

REMOVING SIGNS
10 EA

DATUM
VERTICAL NGVD 1929
HORIZONTAL NAD 1927

| AS-BUILT REVISIONS | | |
|--------------------|---------|------------------------------------|
| NO. | DATE | DESCRIPTION |
| 1. | 8/05/06 | NOTES ADDED PER ENGINEERS MARK UPS |

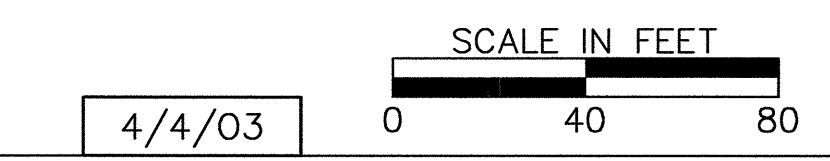

AS-BUILT LEGEND
 PAVEMENT OTHER
 AS-BUILTS

SHELburne - SOUTH BURLINGTON

SURVEYED BY V.S.C. INC. DATE _____
 DRAWN BY E.A.A. INC. DATE _____
 TRACED BY E.A.A. INC. DATE _____

PROJECT NH-EGC-019-4(28)
 SIGN REMOVAL DWG. NO. 1
 SHEET NO. 90 OF 283

K:\03\008 US Rte 7 Shelburne Rd\Drawings\Original Drawings\SIGN REMOVAL\SRM-01_4.DWG, Model: 9/20/2006 2:38:44 PM, parmasa, VT-BRL-HP1055cm, E:\as\Paper\Final\jpc3