


DATUM
 VERTICAL NGVD 1929
 HORIZONTAL NAD 1927

REMOVING SIGNS
 41 EA

AS-BUILT REVISIONS		
NO.	DATE	DESCRIPTION
1.	6/29/06	NOTES ADDED PER ENGINEERS MARK UPS

AS-BUILT LEGEND	
	WATER AS-BUILTS
	SEWER AS-BUILTS
	DRAINAGE AS-BUILTS
	ELECTRICAL AS-BUILTS
	PAVEMENT (OTHER AS-BUILTS)

NOTES:
 1. ALL SIGNS TO BE REMOVED UNLESS OTHERWISE NOTED.
 2. SIGN INVENTORY AS OF NOVEMBER 2002

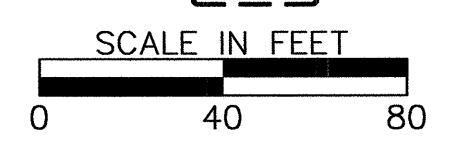

SHELBURNE - SOUTH BURLINGTON
 SURVEYED BY V.S.C. INC. DATE _____
 DRAWN BY E.A.A. INC. DATE _____
 TRACED BY E.A.A. INC. DATE _____
 PROJECT NH-EGC-019-4(28)
 SIGN REMOVAL DWG. NO. 3
 SHEET NO. 92 OF 283

4/4/03