


MATCH TO STRIPING DRAWING NO. 1, STA. 375+00

MATCH TO STRIPING DRAWING NO. 3, STA. 381+00

STA. 376+20.00
 END APPROACH & WIDENING TAPER (TEMPORARY STRIPING)
 BEGIN PROJECT (PERMANENT STRIPING)

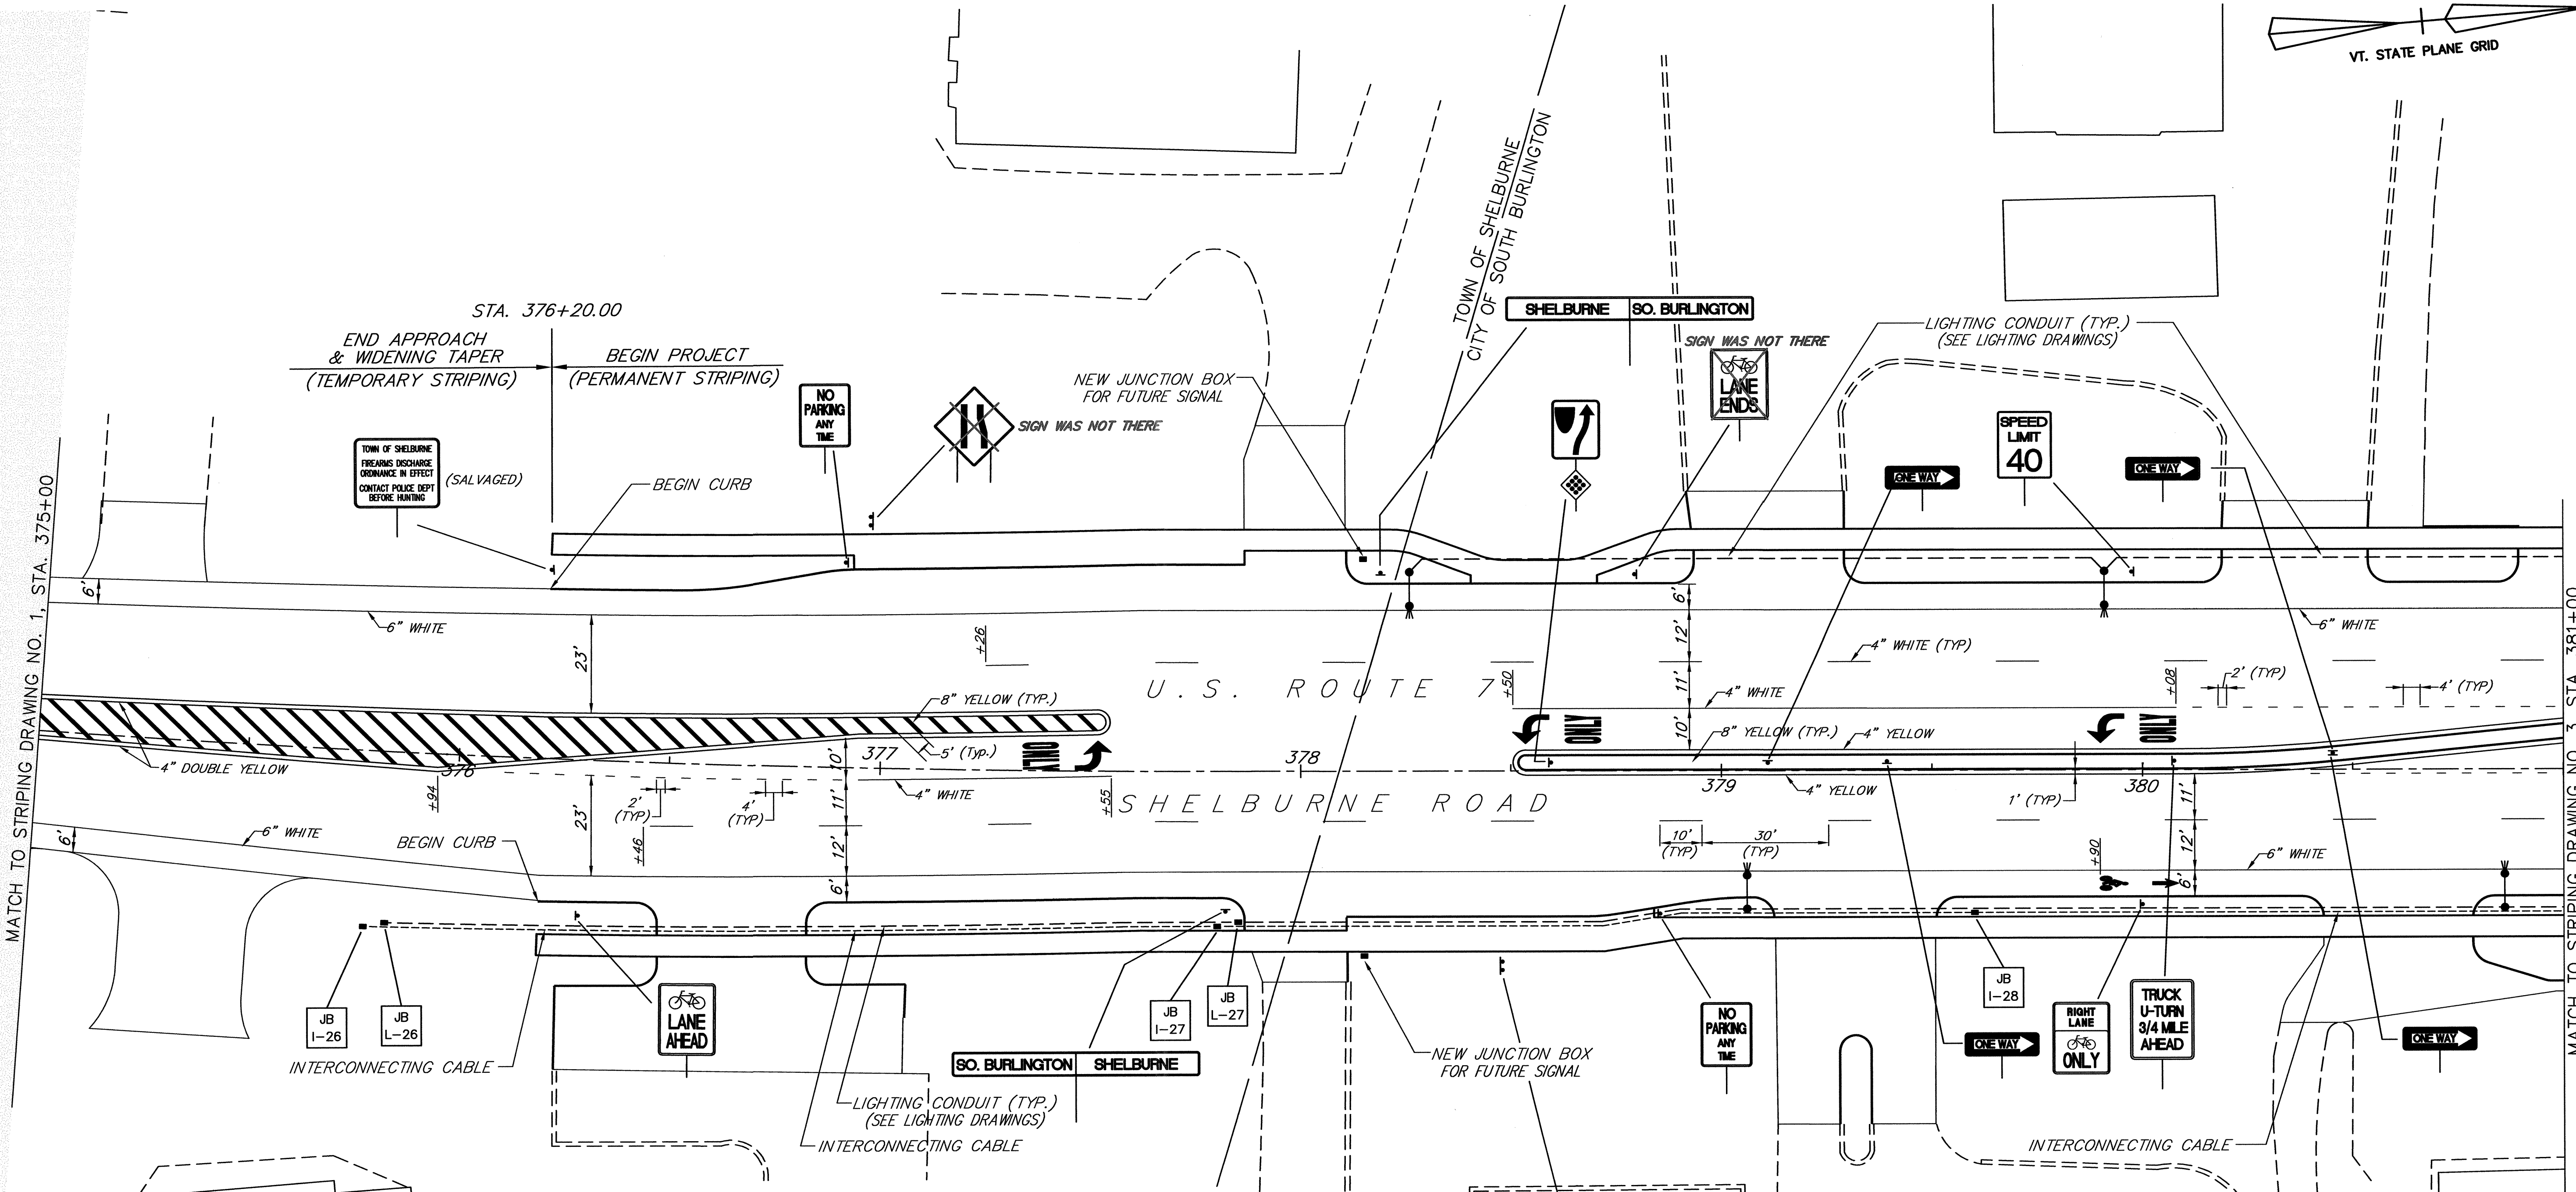

GENERAL NOTES:

- SEE LIGHTING DRAWINGS NO's. 1 THROUGH 10 FOR LIGHTING CONDUITS, JUNCTION BOXES, WIRING AND SLEEVES.
- SEE LIGHTING DRAWINGS NO's. 1 THROUGH 10 FOR INTERCONNECT CONDUITS, JUNCTION BOXES, WIRING AND SLEEVES
- SEE SIGNAL DRAWINGS NO's. 1 THROUGH 6 FOR SIGNAL CONDUITS, PULLBOXES, WIRING, POLES AND SLEEVES.
- INTERCONNECTING CABLE SHALL BE PLACED IN 2" PVC SCHEDULE 40 CONDUIT
- SEE TYPICAL SECTION DRAWING NO. 5 FOR TYPICAL CONDUIT PLACEMENT DETAIL.

LEGEND	
	STREET LIGHT POLE
	UTILITY POLE
	LUMINAIRE
	STRAIN POLE W/ MAST ARM
	PEDESTRIAN POLE
	PULL BOX OR JUNCTION BOX
	SIGNAL CONDUIT
	INTERCONNECT CABLE CONDUIT
	LIGHTING CONDUIT
	SIGN MOUNTING POST(S)
	OVERHEAD MOUNTED SIGN
	PB S-1 = SIGNAL PULLBOX NUMBER
	JB I-1 = INTERCONNECT JUNCTION BOX NUMBER
	JB L-1 = LIGHTING JUNCTION BOX NUMBER
	PB P-1 = POWER SOURCE PULLBOX NUMBER

SIGN NOTES:

- THE CONTRACTOR SHALL PROVIDE APPROPRIATE HARDWARE TO TOP MOUNT THE STREET NAME SIGNS, INCIDENTAL TO THE TRAFFIC SIGN ITEMS.
- SIGNS ON THE MAST ARMS SHALL BE MOUNTED WITH BLACK HARDWARE ARE TO MATCH THE MAST ARM AND SHALL BE PAID UNDER ITEM 675.20, TRAFFIC SIGNS, TYPE A.
- ALL SIGNS AND POSTS ARE NEW UNLESS OTHERWISE NOTED.
- CCTA BUS STOP SIGNS TO BE OBTAINED FROM CCTA.

- (SALVAGED)
- (SALVAGED)
- (SALVAGED) SIGN WAS NOT THERE

AS-BUILT LEGEND	
	WATER AS-BUILTS
	SEWER AS-BUILTS
	DRAINAGE AS-BUILTS
	ELECTRICAL AS-BUILTS
	PAVEMENT/OTHER AS-BUILTS


AS-BUILT REVISIONS	
NO.	DATE DESCRIPTION
1.	6/29/06 NOTES ADDED PER ENGINEERS MARK UPS

ERECTING SALVAGED SIGNS	
4	EA

SHELBURNE - SOUTH BURLINGTON

SURVEYED BY: V.S.C. INC. DATE _____
 DRAWN BY: E.A.A. INC. DATE _____
 TRACED BY: E.A.A. INC. DATE _____

PROJECT NH-EGC-019-4(28)
 SIGN AND STRIPING DRAWING NO. 2
 SHEET NO. 94 OF 283

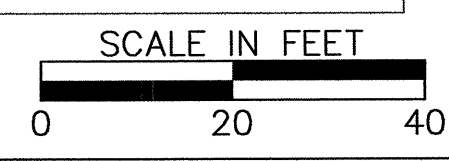

4/4/03

DATUM
 VERTICAL NGVD 1929
 HORIZONTAL NAD 1927