

SLEEVE LOCATIONS

405+47, 33.2' RT. - 405+47, 50.4' LT.
405+64, 46.5' RT. - 406+19, 46.5' RT.
405+64, 62.0' LT. - 406+17, 66.1' LT.

SIGNAL ITEMS

ITEM 678.26 - JUNCTION BOX

406+21, 66' LT (S-14A)

ITEM 678.27 - PULLBOX - DOUBLE

405+47, 46' RT (S-13)
 405+51, 64' LT (S-13B)
 406+28, 46' RT (S-14)



LIGHTING ITEMS

ITEM 678.26 - JUNCTION BOX


405+41, 37' RT (L-37)
 406+27, 64' LT (L-38)
 406+46, 45' RT (L-39)

ITEM 678.26 (MOD.) - JUNCTION BOX

405+42, 55' LT (L-36)

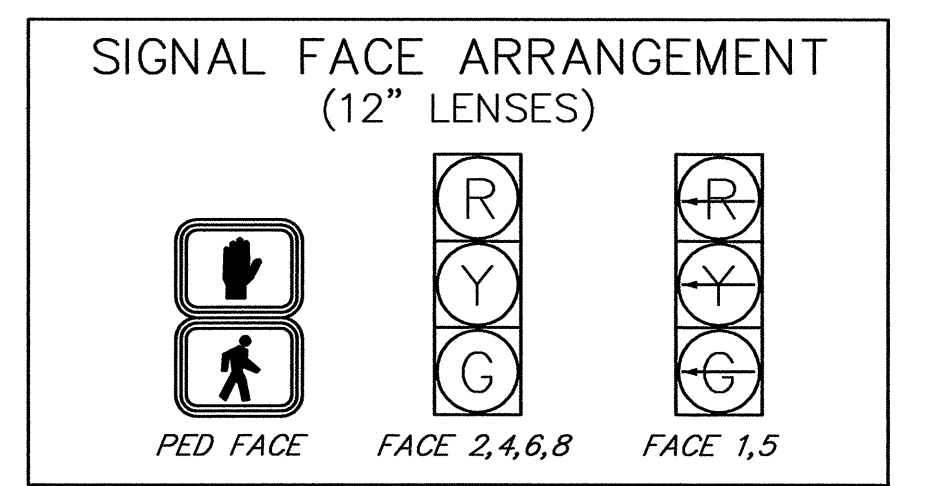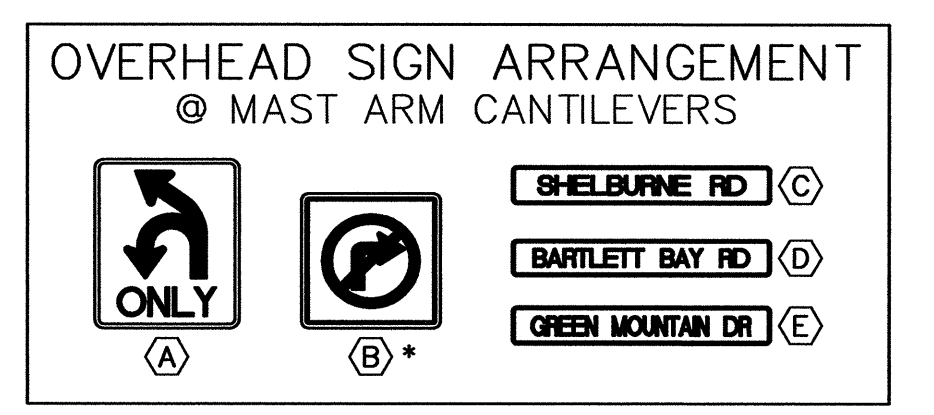


FROM	TO	ITEM 678.20 (MOD.) INTERCONNECT CONDUIT	ITEM 678.21 ELECTRICAL CONDUIT	ITEM 678.23 WIRE CONDUIT		ITEM 678.30 ELECTRICAL CONDUIT SLEEVE		DESCRIPTION
				2"	2 1/2"	8"	12"	
POWER SOURCE	STANCHION				45			SIGNAL / VAOT LIGHTING - POWER
POWER SOURCE	STANCHION				45			SOUTH BURLINGTON LIGHTING
STANCHION	JB S-14A			10				SIGNAL - POWER
STANCHION	JB S-14A			10				VAOT LIGHTING - POWER
STANCHION	JB L-38			10				SOUTH BURLINGTON LIGHTING
LOOP #5	JB S-14A			33				LOOP #5
PED POLE	JB S-14A			26				SIGNAL
JB L-38	JB L-36			88				SOUTH BURLINGTON LIGHTING
JB S-14A	PB S-13A			70				LOOP #5
JB S-14A	PB S-13A			70				SIGNAL - POWER
JB S-14A	PB S-13A			70			53	SPARE
JB S-14A	PB S-13A			70				SIGNAL
JB S-14A	PB S-13A			70				VAOT LIGHTING
CANTILEVER #11	PB S-13A			17				SIGNAL
CANTILEVER #11	PB S-13A			17				VAOT LIGHTING
CANTILEVER #9	PB S-13A			27				PRE-EMPTION
CANTILEVER #9	PB S-13A			27				SIGNAL
LOOP #4A & 4B	PB S-13A			30				LOOP #4A & 4B
LIGHT POLE V3	PB S-13A			29				SIGNAL
LIGHT POLE V3	PB S-13A			29				VAOT LIGHTING
JB L-36	JB L-37			98				SOUTH BURLINGTON LIGHTING
PB S-13A	PB S-13			112				LOOP #4A, 4B & 5 / PRE-EMPTION
PB S-13A	PB S-13			112				SIGNAL - POWER
PB S-13A	PB S-13			100			84	SPARE
PB S-13A	PB S-13			112				SIGNAL
PB S-13A	PB S-13			112				VAOT LIGHTING
JB I-38	PB S-13	48						INTERCONNECT
PED POLE	PB S-13			23				SIGNAL
LOOP #1	PB S-13			31				LOOP #1
CANTILEVER #10	PB S-13			14				SIGNAL
CANTILEVER #10	PB S-13			14				SPARE
LIGHT POLE V4	PB S-13			22				VAOT LIGHTING
JB L-37	JB L-39			99				SOUTH BURLINGTON LIGHTING
PB S-13	PB S-14	82						INTERCONNECT
PB S-13	PB S-14			82				LOOP #1, 4A, 4B & 5 / PRE-EMPTION
PB S-13	PB S-14			82				SIGNAL - POWER
PB S-13	PB S-14			82			56	SPARE
PB S-13	PB S-14			82				SIGNAL
PB S-13	PB S-14			82				VAOT LIGHTING
CANTILEVER #12	PB S-14			13				PRE-EMPTION
CANTILEVER #12	PB S-14			13				VAOT LIGHTING
CANTILEVER #12	PB S-14			13				SIGNAL
PB S-14	CONTROLLER	18						INTERCONNECT
PB S-14	CONTROLLER			18				LOOPS / PRE-EMPTION
PB S-14	CONTROLLER			18				SIGNAL - POWER
PB S-14	CONTROLLER			18				SIGNAL
LOOP #8A & #8B	CONTROLLER			31				LOOP #8A & #8B
CONTROLLER	JB I-39	68						INTERCONNECT
TOTAL		216	266	1820	90		193	

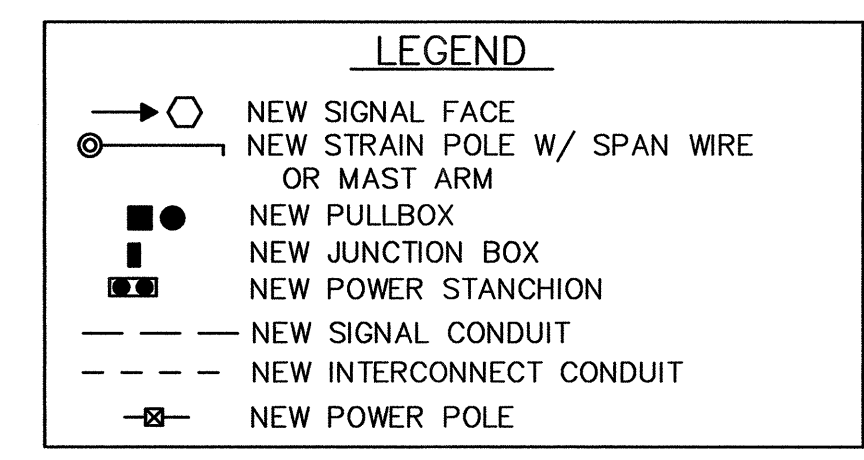

AS-BUILT REVISIONS

NO.	DATE	DESCRIPTION
1.	3/7/06	SIGNAL ARRANGEMENT & SLEEVES ADDED

NOTE:
 SEE SIGNAL DRAWING NOS. 1 & 2 FOR:
 TRAFFIC SIGNAL & GENERAL NOTES AND
 LIST OF MAJOR EQUIPMENT.

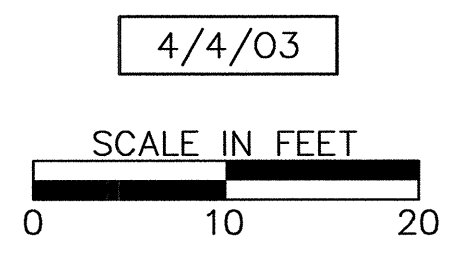

SHELburne - SOUTH BURLINGTON

SURVEYED BY V.S.C. INC. DATE _____
 DRAWN BY E.A.A. INC. DATE _____
 TRACED BY E.A.A. INC. DATE _____

REVISED SIGNAL DESIGN
 PROJECT NH-EGC-019-4(28)
 SIGNAL DRAWING NO. 5
 SHEET NO. 130A OF 283

DATUM VERTICAL NGVD 1929 HORIZONTAL NAD 1927

INTERSECTION NO. MS-516 (US 7 - BARTLETT BAY ROAD)