


# LANDSCAPE QUANTITY SHEET

QUANTITY	UNIT	KEY	BOTANICAL NAME	COMMON NAME	SIZE	TYPE	REMARKS	ITEM #
<b>SMALL DECIDUOUS TREES</b>								656.30
<del>13</del>	<del>EA</del>	<del>MST</del>	<del>Acer tomentosum</del>	<del>SUGAR TREE CRABAPPLE</del>	<del>1 3/4" - 2" CAL</del>			
<del>21</del>	<del>EA</del>	<del>AGR</del>	<del>Acer tomentosum</del>	<del>TATARIAN MAPLE</del>	<del>1 3/4" - 2" CAL</del>	B&B		
<del>30</del>	<del>EA</del>	<del>ATT</del>	<del>Acer tomentosum</del>	<del>TATARIAN MAPLE</del>	<del>1 3/4" - 2" CAL</del>	B&B		
<del>22</del>	<del>EA</del>	<del>ATS</del>	<del>Acer tomentosum</del>	<del>TATARIAN MAPLE</del>	<del>1 3/4" - 2" CAL</del>	B&B		
18	EA	ALS	Amelanchier laevis "Snowcloud"	SNOWCLOUD SERVICEBERRY	1 3/4" - 2" CAL	B&B	SPRING PLANTING	
7	EA	MDC	Malus "Spring Snow"	SPRING SNOW CRABAPPLE	1 3/4" - 2" CAL	B&B		
14	EA	MSS	Malus "Spring Snow"	SPRING SNOW CRABAPPLE	1 3/4" - 2" CAL	B&B		
4	EA	PCC	Malus "Harvest Gold"	HARVEST GOLD CRABAPPLE	1 3/4" - 2" CAL	B&B		
18	EA	PCV	Malus "Harvest Gold"	HARVEST GOLD CRABAPPLE	1 3/4" - 2" CAL	B&B		
20	EA	PUB	Malus "Harvest Gold"	HARVEST GOLD CRABAPPLE	1 3/4" - 2" CAL	B&B		
28 + 6	EA	SRS	Syringa reticulata "Ivory Silk"	IVORY SILK TREE LILAC	1 3/4" - 2" CAL	B&B		
149	SUBTOTAL		EGF, per Addendum					
<b>MEDIUM DECIDUOUS TREES</b>								656.30
21 + 17	EA	ATN	Pyrus calleryana "Cleveland Select"	CLEVELAND SELECT PEAR	2" - 2 1/2" CAL	B&B	SPRING PLANTING	
4	EA	PCS	Pyrus calleryana "Cleveland Select"	CLEVELAND SELECT PEAR	2" - 2 1/2" CAL	B&B	SPRING PLANTING	
3	EA	SJP	Sophora japonica "Princeton"	PRINCETON UPRIGHT SCHOLAR TREE	2" - 2 1/2" CAL	B&B		
24	SUBTOTAL							
<b>LARGE DECIDUOUS TREES</b>								656.30
3	EA	ARM	RED OAK <small>PER C.B. 10/04</small>	PATMORE GREEN ASH HACKBERRY	2 1/2" - 3" CAL	B&B		
24	EA	FPP	Fraxinus pennsylvanica "Patmore"	SUMMIT GREEN ASH <small>Autumn Blaze Maple</small>	1 1/2" - 3" CAL	B&B		
24	EA	FPS	Fraxinus pennsylvanica "Summit"	SUMMIT GREEN ASH	1 1/2" - 3" CAL	B&B	SPRING PLANTING	
2	EA	QRB	Quercus rubra	RED OAK	2 1/2" - 3" CAL	B&B		
48	SUBTOTAL							
<b>DECIDUOUS SHRUBS</b>								656.35
40	EA	MMU	Mystic Meidiland	MYSTIC MEIDLAND ROSE	24"	NO. 2 CONTAINER	SEE BUS SHELTER PLANTING DETAIL, THIS SHEET	


APPROXIMATE SUMMARY OF QUANTITIES			
QUANTITY	UNIT	ITEMS	ITEM NO.
1360	LF	6" UNDERDRAIN (MOD)	605.10
75	MGAL	DUST CONTROL WITH WATER (MOD)	609.10
1	LS	IRRIGATION SYSTEM	629.45
370	CY	TOPSOIL	651.35
149	EA	SMALL DECIDUOUS TREES	656.30
24	EA	MEDIUM DECIDUOUS TREES	656.30
48	EA	LARGE DECIDUOUS TREES	656.30
40	EA	DECIDUOUS SHRUBS	656.35

### GENERAL NOTES

- SEED MIXTURE: SHALL NOT HAVE A WEED CONTENT EXCEEDING 0.40% BY WEIGHT AND SHALL BE FREE OF ALL NOXIOUS SEED.
- SEED: USE VAOT'S "URBAN MIX" FOR ALL LAWN AREAS
- FERTILIZER: FORMULA 5-10-10, TO BE USED WITH SEED, APPLIED AT THE RATE OF 4 LBS./1000 SF OR 300 LBS/ACRE. (HYDRO SEEDERS MAY USE 19-19-19 FORMULA)
- LIME: PELLETIZED AGRICULTURAL LIMESTONE TO BE APPLIED AT THE RATE OF 100LBS/1000 SF OR 2 TONS/ACRE, OR AS DIRECTED BY THE ENGINEER.
- HAY MULCH: HAY OR STRAW, AIR DRIED AND FREE FROM UNDESIREABLE SEEDS AND COARSE MATERIAL, TO BE APPLIED AT THE RATE OF 75 TO 100 LBS/1000 SF, OR 2 TONS/ACRE, OR AS DIRECTED BY THE ENGINEER.
- TOPSOIL: TO BE USED WITH SEED AS INDICATED ON THE PLANS, OR AS DIRECTED BY THE ENGINEER.
- TOPSOIL BACKFILL FOR TREE PLANTING: USE NATIVE SOIL, DUG FROM PLANTING HOLES, UNLESS THE SOIL IS OF POOR QUALITY (IE, SANDY, EXCESSIVELY DRAINED SOIL, OR CLAY, POORLY DRAINED SOIL, OR OTHER UNDESIRABLE FILL MATERIAL). REPLACE POOR QUALITY SOIL WITH IMPORTED TOPSOIL, OR A MIX OF NATIVE SOIL AND TOPSOIL, OR A MIX OF NATIVE SOIL AND COMMERCIALY PREPARED COMPOST AS DIRECTED BY THE ENGINEER.
- IMPORTED TOPSOIL: IMPORTED TOPSOIL SHALL BE FERTILE, FRIABLE, SANDY LOAM CONTAINING A MINIMUM OF 1.5% BY DRY WEIGHT OF ORGANIC MATTER, FREE FROM SUBSOIL, REFUSE, DEBRIS, ROOTS, HEAVY CLAY, STONES LARGER THAN .5 INCH, NOXIOUS WEED SEEDS, AND SUITABLE FOR THE GERMINATION OF SEEDS AND THE SUPPORT OF HEALTHY VEGETATIVE GROWTH WITH A pH VALUE OF 5.5 TO 6.5.
- TREES: ALL TREES TO BE GROWN AS TREE FORMS AND MUST BE TRAINED IN THE NURSERY TO A SINGLE STRAIGHT TRUNK. TREES THAT ARE PLANTED 2'-3' FROM THE EDGE OF THE SIDEWALK SHALL HAVE A SINGLE STRAIGHT TRUNK TO 6' WITH LOWER 4'-5' CLEAR OF BRANCHES.
- TREE LOCATIONS: TREES AND SHRUBS MAY BE ADJUSTED AT THE TIME OF THEIR PLANTING FOR OPTIMUM LOCATION AS DIRECTED BY THE ENGINEER. MINIMUM DISTANCE FROM TREES TO LIGHT POLES SHALL BE 15'.
- TREE PLANTING: SPRING TREE PLANTING: MAY 1 - JUNE 15  
FALL TREE PLANTING: SEPT 1 - OCTOBER 15

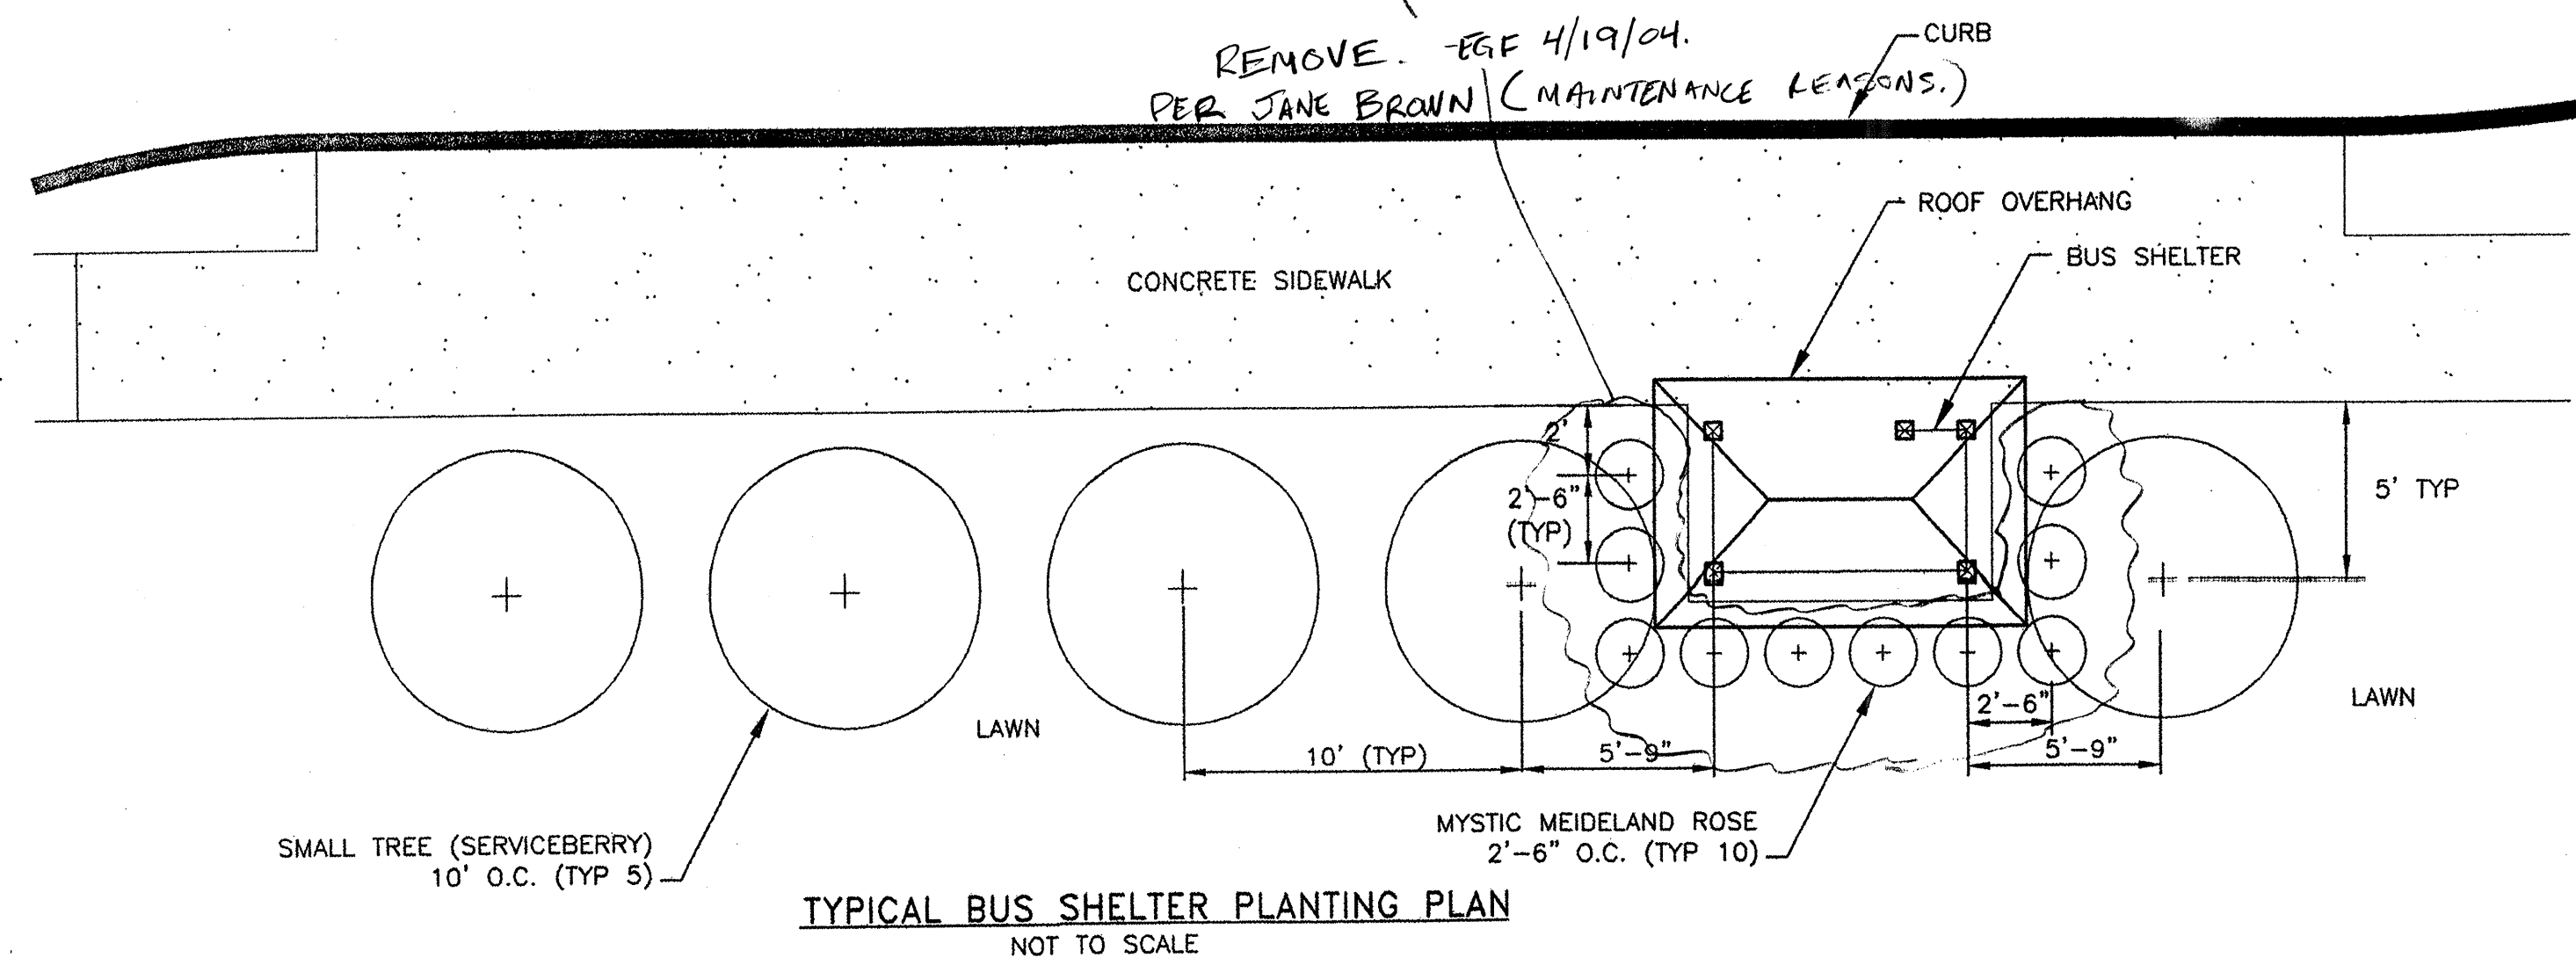

DATUM  
VERTICAL \_\_\_\_\_  
HORIZONTAL \_\_\_\_\_

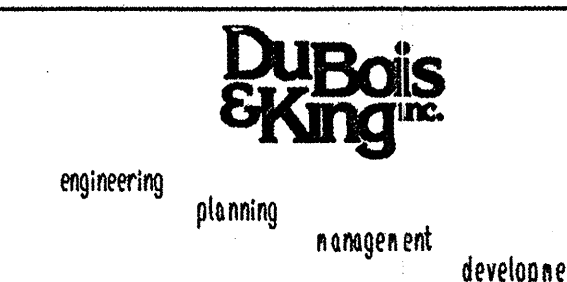

**LANDSCAPE QUANTITY SHEET**

PROJECT: U.S. ROUTE 7	PROJECT NO.: NH-EGC-019-4(28)
DESIGN FILE NAME: C15851C4-01	PLOT DATE: 4/4/03
IPARM FILE NAME:	SURVEY DATE:
SURVEYED BY:	DRAWN BY: K. KOLOSKI
SQUAD LEADER: JOHN STEELE	SHEET: L1 OF L14