


MATCH TO PLAN DRAWING NO. L4, STA. 381+00

AS-BUILT REVISIONS		
NO.	DATE	DESCRIPTION
1.	6/30/06	TREE TYPES ADDED TO PLANS


AS-BUILT LEGEND	
	WATER AS-BUILTS
	SEWER AS-BUILTS
	DRAINAGE AS-BUILTS
	ELECTRICAL AS-BUILTS
	PAVEMENT / OTHER AS-BUILTS

LEGEND

- EXISTING TREELINE
- EXISTING DECIDUOUS TREE
- TOE OF SLOPE
- TOP OF CUT
- PROPOSED DECIDUOUS TREE WITH PLANT TYPE AND PAY ITEM
- EXISTING TREE TO BE SAVED
- UTILITY POLE
- STREET LIGHT

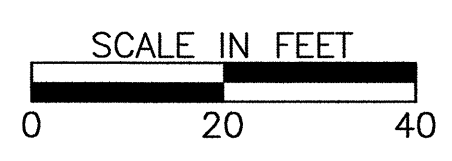

DATUM	_____
VERTICAL	_____
HORIZONTAL	_____

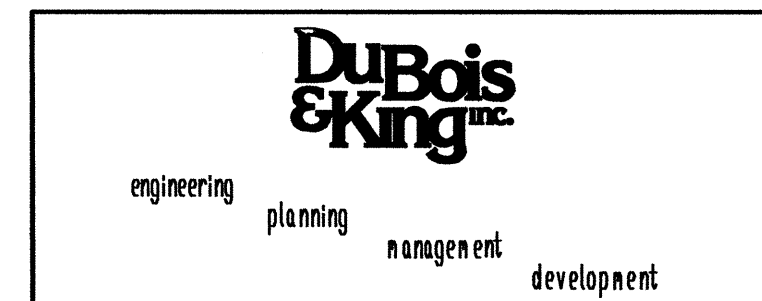

LANDSCAPE PLAN
STA 375+00 TO 381+00

PROJECT: U.S. ROUTE 7
DESIGN FILE NAME:
IPARM FILE NAME:
SURVEYED BY: V.S.C. INC.
SQUAD LEADER: JOHN STEELE

SHEET NO. 164 OF 283
PROJECT NO.: NH-EGC-019-4(28)
PLOT DATE: 4/4/03
SURVEY DATE:
DRAWN BY: K. KOLOSKI
SHEET: L3 OF L14