

**AS-BUILT REVISIONS**


NO.	DATE	DESCRIPTION
1.	6/30/06	TREE TYPES ADDED TO PLANS

**AS-BUILT LEGEND**

	WATER AS-BUILTS
	SEWER AS-BUILTS
	DRAINAGE AS-BUILTS
	ELECTRICAL AS-BUILTS
	PAVEMENT/OTHER AS-BUILTS


**LEGEND**

	EXISTING TREELINE
	EXISTING DECIDUOUS TREE
	TOE OF SLOPE
	TOP OF CUT
	PROPOSED DECIDUOUS TREE WITH PLANT TYPE AND PAY ITEM
	EXISTING TREE TO BE SAVED
	UTILITY POLE
	STREET LIGHT

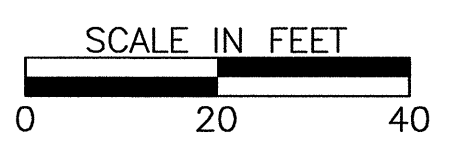

**DATUM**

VERTICAL	_____
HORIZONTAL	_____

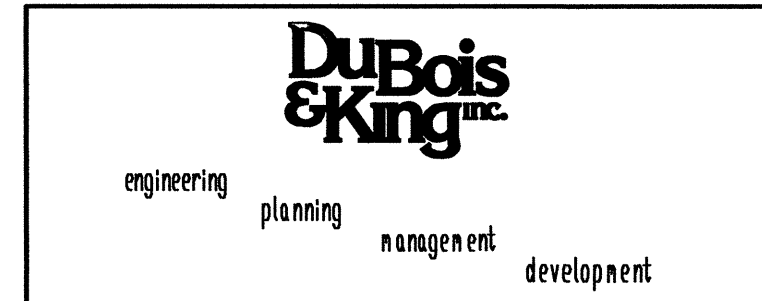

**LANDSCAPE PLAN**  
STA 381+00 TO 387+00

PROJECT: U.S. ROUTE 7  
DESIGN FILE NAME:  
IPARM FILE NAME:  
SURVEYED BY: V.S.C. INC.  
SQUAD LEADER: JOHN STEELE

SHEET NO. 165 OF 283  
PROJECT NO. : NH-EGC-019-4(28)  
PLOT DATE: 4/4/03  
SURVEY DATE:  
DRAWN BY: K. KOLOSKI  
SHEET: L4 OF L14