


MATCH TO PLAN DRAWING NO. L5, STA. 393+00

MATCH TO PLAN DRAWING NO. L7, STA. 399+00

LEGEND

- EXISTING TREELINE
- EXISTING DECIDUOUS TREE
- TOE OF SLOPE
- TOP OF CUT
- AP.01 PROPOSED DECIDUOUS TREE WITH PLANT TYPE AND PAY ITEM
- EXISTING TREE TO BE SAVED
- UTILITY POLE
- STREET LIGHT

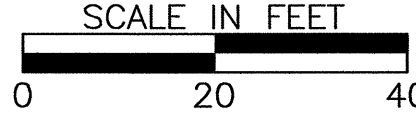

AS-BUILT REVISIONS


NO.	DATE	DESCRIPTION
1.	7/5/06	TREE TYPES ADDED TO PLANS

AS-BUILT LEGEND

	WATER AS-BUILTS
	SEWER AS-BUILTS
	DRAINAGE AS-BUILTS
	ELECTRICAL AS-BUILTS
	PAVEMENT OTHER AS-BUILTS

DATUM

VERTICAL	_____
HORIZONTAL	_____

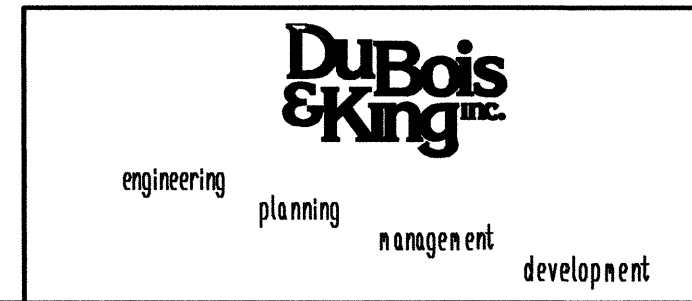

LANDSCAPE PLAN
STA 393+00 TO 399+00

PROJECT: U.S. ROUTE 7
DESIGN FILE NAME:
IPARM FILE NAME:
SURVEYED BY: V.S.C. INC.
SQUAD LEADER: JOHN STEELE

SHEET NO. 167 OF 283
PROJECT NO.: NH-EGC-019-4(28)
PLOT DATE: 4/4/03
SURVEY DATE:
DRAWN BY: K. KOLOSKI
SHEET: L6 OF L14