
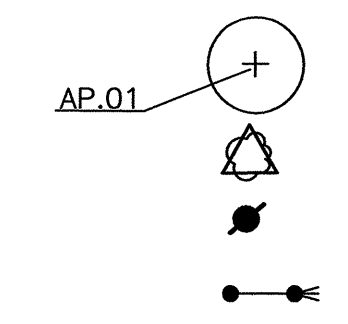


MATCH TO PLAN DRAWING NO. L9, STA. 417+00

MATCH TO PLAN DRAWING NO. L11, STA. 423+00

DATUM

VERTICAL	_____
HORIZONTAL	_____

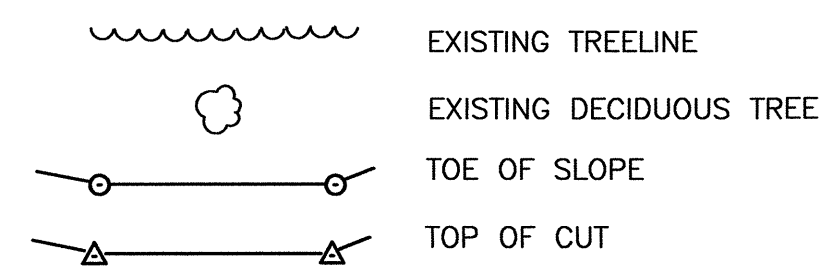


PROPOSED DECIDUOUS TREE WITH PLANT TYPE AND PAY ITEM

EXISTING TREE TO BE SAVED

UTILITY POLE

STREET LIGHT

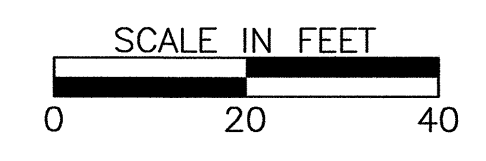


AS-BUILT REVISIONS

NO.	DATE	DESCRIPTION
1.	7/05/06	TREE TYPES ADDED TO PLANS

AS-BUILT LEGEND

	WATER AS-BUILTS
	SEWER AS-BUILTS
	DRAINAGE AS-BUILTS
	ELECTRICAL AS-BUILTS
	PAVEMENT / OTHER AS-BUILTS

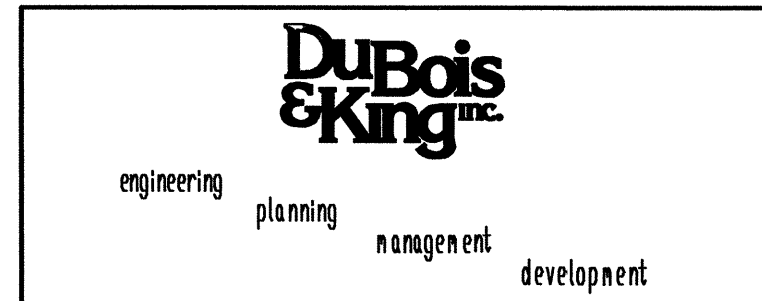

LANDSCAPE PLAN

STA 417+00 TO 423+00

PROJECT: U.S. ROUTE 7

DESIGN FILE NAME:
IPARM FILE NAME:
SURVEYED BY: V.S.C. INC.
SQUAD LEADER: JOHN STEELE

SHEET NO. 171 OF 283

PROJECT NO.: NH-EGC-019-4(28)

PLOT DATE: 4/4/03

SURVEY DATE:
DRAWN BY: K. KOLOSKI

SHEET: L10 OF L14