

MATCH TO PLAN DRAWING NO. L10, STA. 423+00

END OF PROJECT, STA. 428.95

NO.	DATE	DESCRIPTION
1.	7/5/06	TREE TYPES ADDED TO PLANS



AS-BUILT LEGEND	
	WATER AS-BUILTS
	SEWER AS-BUILTS
	DRAINAGE AS-BUILTS
	ELECTRICAL AS-BUILTS
	PAVEMENT / OTHER AS-BUILTS

LEGEND

DATUM	_____
VERTICAL	_____
HORIZONTAL	_____

- EXISTING TREELINE
- EXISTING DECIDUOUS TREE
- TOE OF SLOPE
- TOP OF CUT

- AP.01 PROPOSED DECIDUOUS TREE WITH PLANT TYPE AND PAY ITEM
- EXISTING TREE TO BE SAVED
- UTILITY POLE
- STREET LIGHT

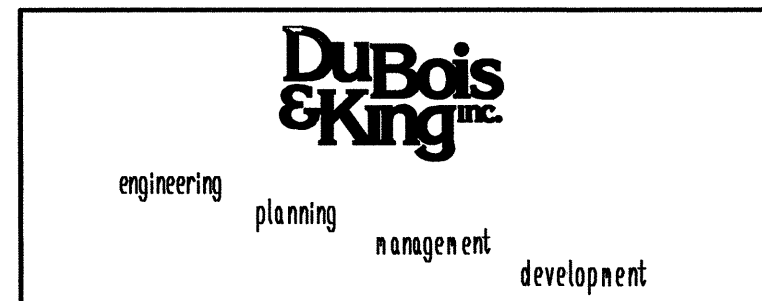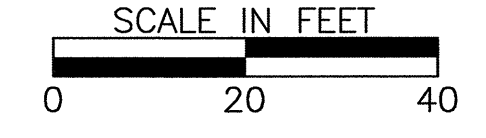

LANDSCAPE PLAN
STA 423+00 TO 428+95

PROJECT: U.S. ROUTE 7
DESIGN FILE NAME:
IPARM FILE NAME:
SURVEYED BY: V.S.C. INC.
SQUAD LEADER: JOHN STEELE

SHEET NO. 172 OF 283
PROJECT NO.: NH-EGC-019-4(28)
PLOT DATE: 4/4/03
SURVEY DATE:
DRAWN BY: K. KOLOSKI
SHEET: L11 OF L14