


DATUM ELEV = 180.00

DATUM ELEV = 185.00

DATUM ELEV = 180.00

DATUM ELEV = 185.00

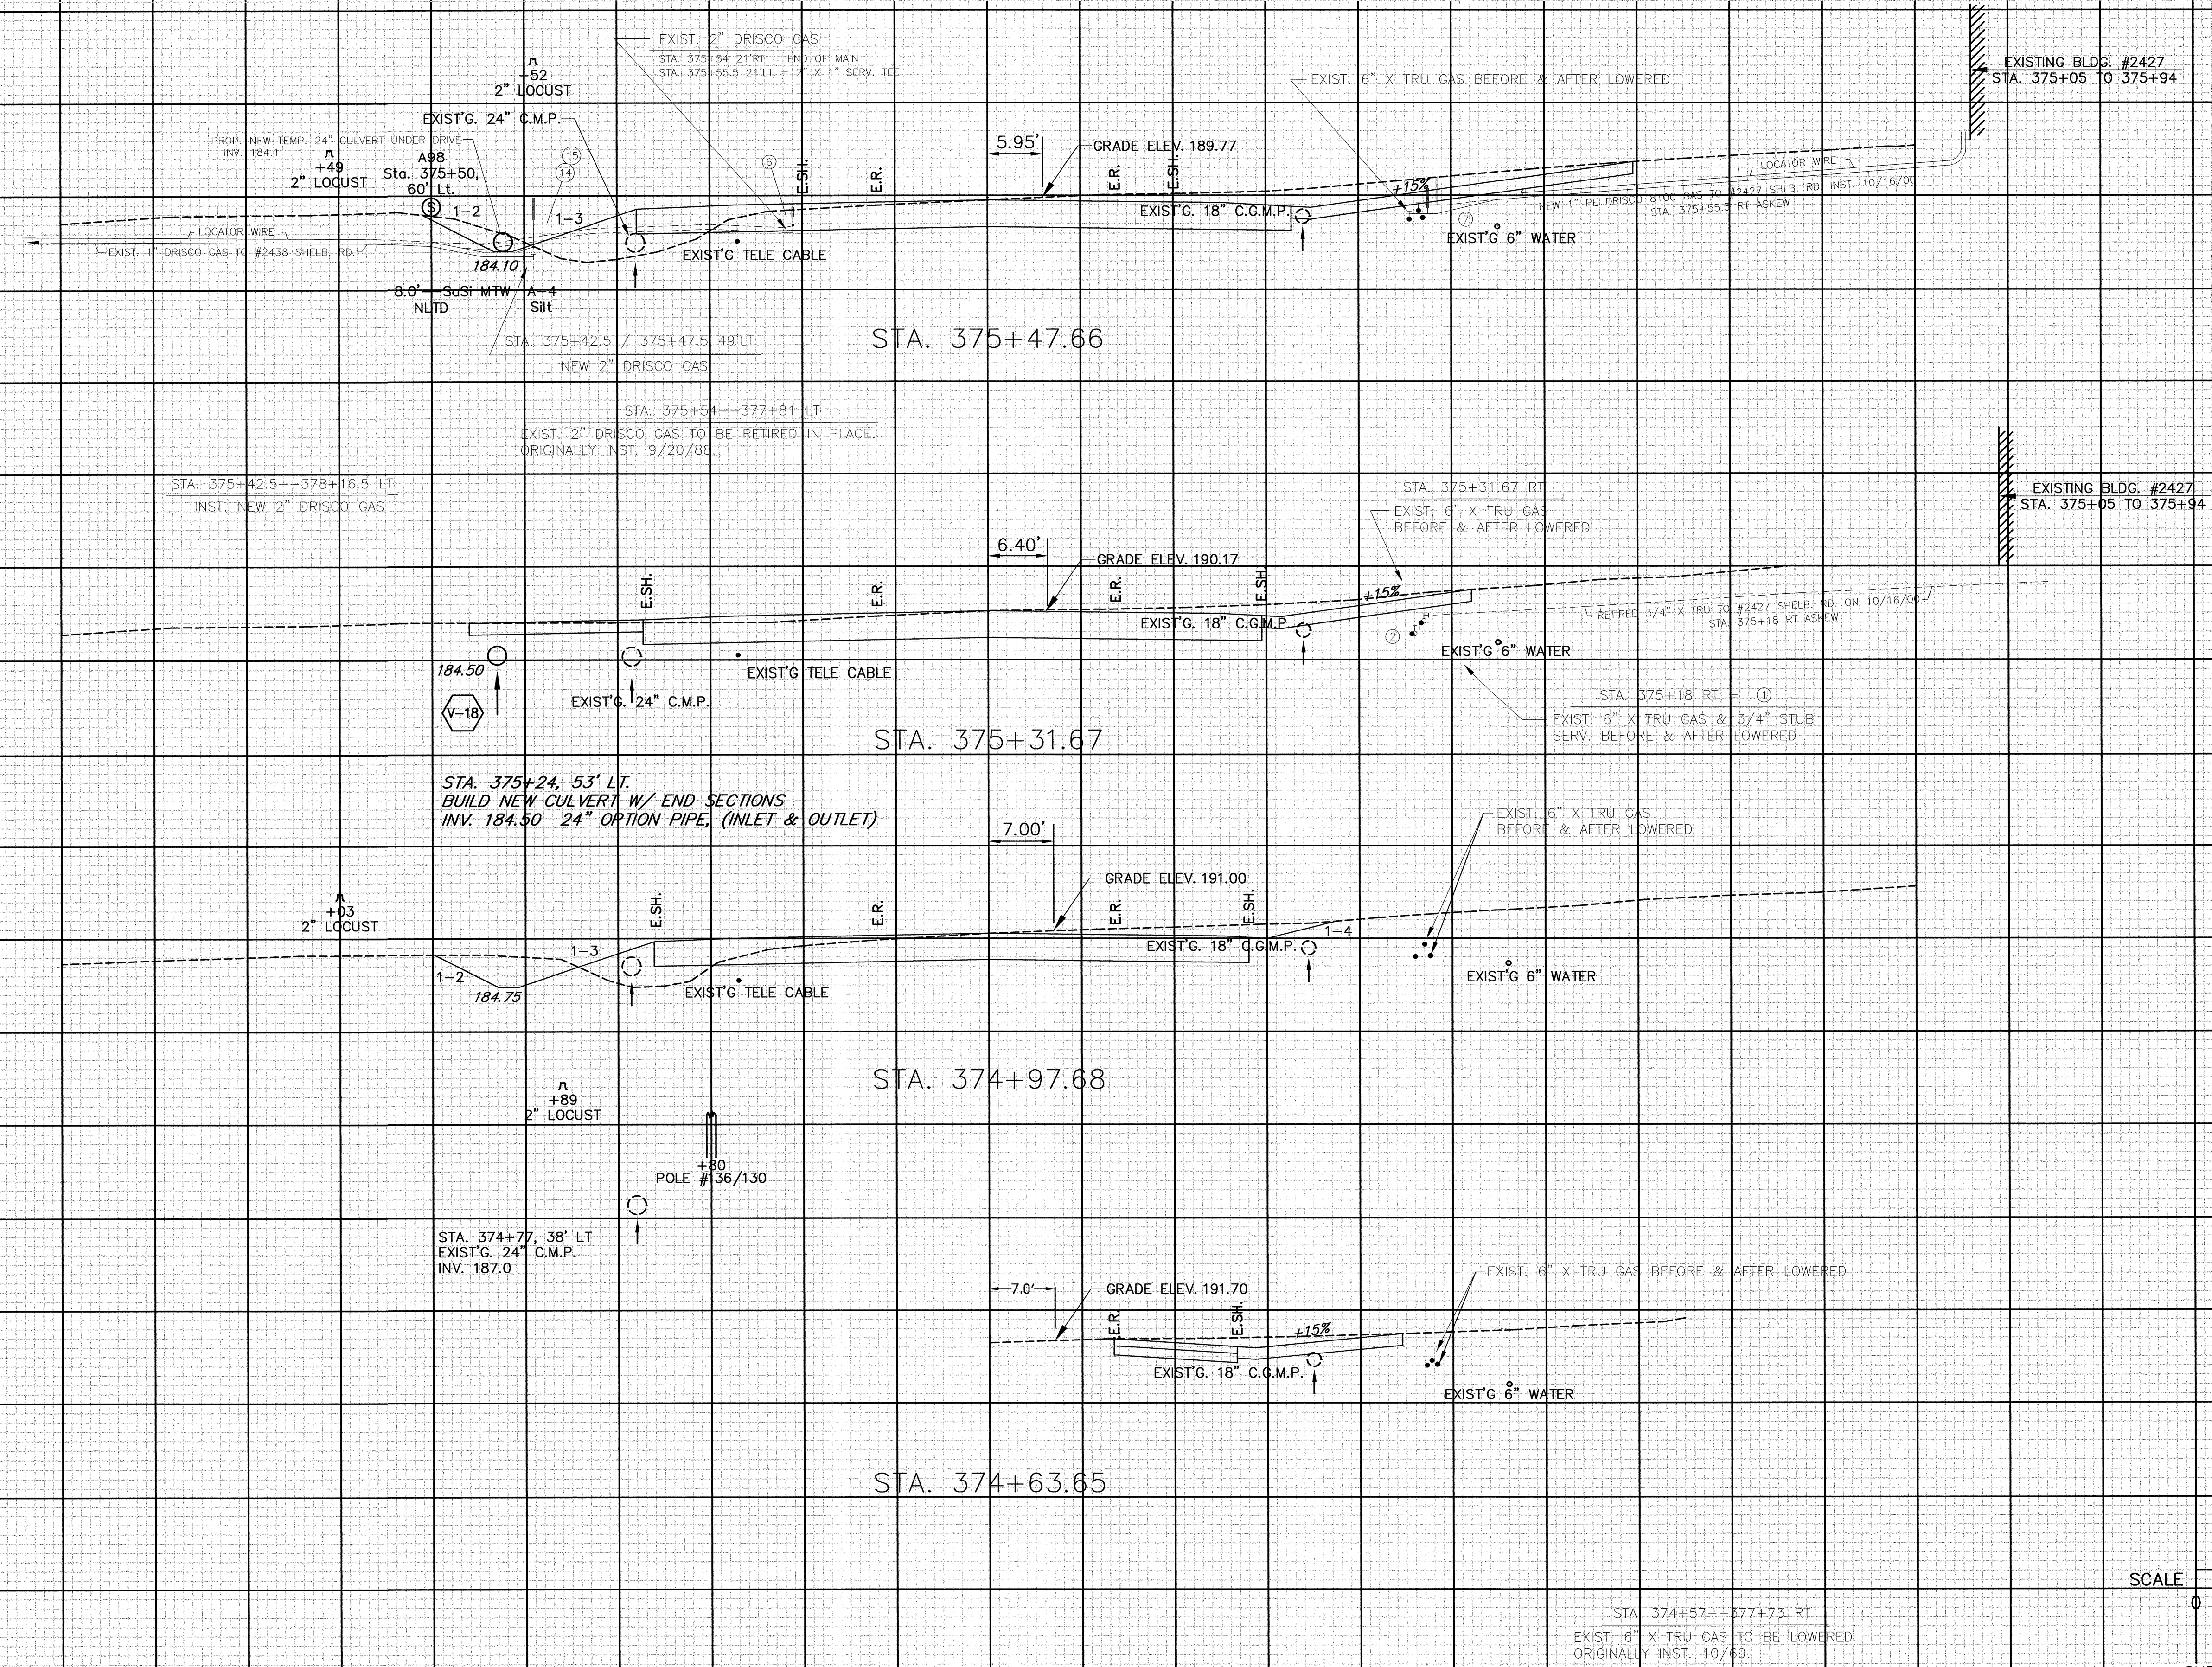

EXISTING BLDG. #2427
STA. 375+05 TO 375+94

EXISTING BLDG. #2427
STA. 375+05 TO 375+94

SCALE 0 10 20 FT.

SHELburne - SOUTH BURLINGTON
 STA. 374+64 TO STA. 375+48
 SURVEYED BY V.S.C. INC. DATE _____
 DRAWN BY E.A.A. INC. DATE _____
 TRACED BY E.A.A. INC. DATE _____
 PROJECT NH-EGC-019-4(28)
 CROSS-SECTION DWG. NO. 87
 SHEET 179 OF 283

AS-BUILT REVISIONS	
NO.	DESCRIPTION
1.	8/29/06 CHANGES MADE PER AS-BUILTS MARK UPS

ERDMAN ANTHONY
 CONSULTING ENGINEERS
 Rochester, New York Camp Hill, Pennsylvania
 Boston, Massachusetts