

DATUM ELEV = 180.00

DATUM ELEV = 180.00

DATUM ELEV = 180.00

DATUM ELEV = 170.00


+85
2" MAPLE

+43
2" MAPLE

+71
2" LOCUST

ERDMAN ANTHONY
CONSULTING ENGINEERS
Rochester, New York Camp Hill, Pennsylvania
Boston, Massachusetts

130 120 110 100 90 80 70 60 50 40 30 20 10 0 10 20 30 40 50 60 70 80 90 100 110 120

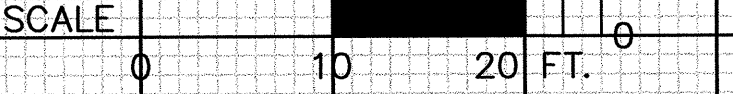

SHELburne - SOUTH BURLINGTON

STA. 376+00 TO STA. 377+00

SURVEYED BY V.S.C. INC. DATE _____
DRAWN BY E.A.A. INC. DATE _____
TRACED BY E.A.A. INC. DATE _____

PROJECT NH-EGC-019-4(28)

CROSS-SECTION DWG. NO. 88

SHEET 180 OF 283

AS-BUILT REVISIONS		
NO.	DATE	DESCRIPTION
1.	8/29/06	CHANGES MADE PER AS-BUILTS MARK UPS

4/4/03