


DATUM ELEV = 160.00

DATUM ELEV = 160.00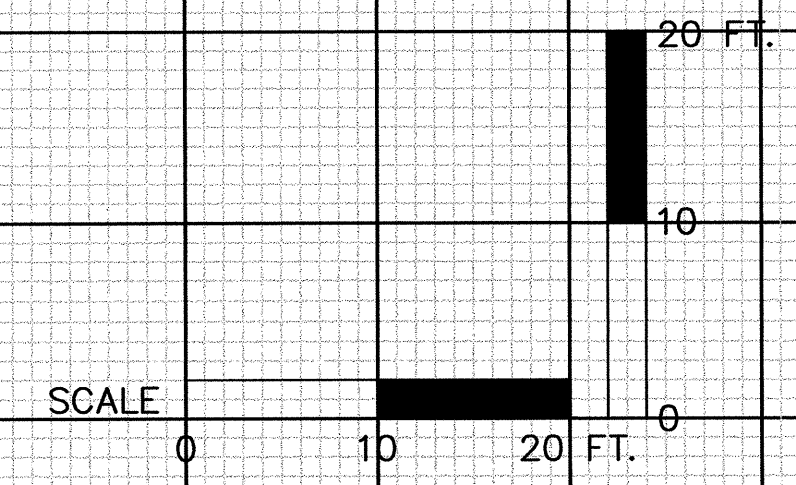

ERDMAN ANTHONY
CONSULTING ENGINEERS
Rochester, New York Camp Hill, Pennsylvania
Boston, Massachusetts

AS-BUILT REVISIONS	
NO.	DESCRIPTION
1.	8/29/06 CHANGES MADE PER AS-BUILTS MARK UPS

SHELBURNE - SOUTH BURLINGTON
STA. 382+68 TO STA. 383+65
SURVEYED BY V.S.C. INC. DATE _____
DRAWN BY E.A.A. INC. DATE _____
TRACED BY E.A.A. INC. DATE _____
PROJECT NH-EGC-019-4(28)
CROSS-SECTION DWG. NO. 92
SHEET 184 OF 283