


**ERDMAN ANTHONY**  
CONSULTING ENGINEERS  
Rochester, New York    Camp Hill, Pennsylvania  
Boston, Massachusetts

AS-BUILT REVISIONS		REVISED SEWER DESIGN
NO.	DATE	DESCRIPTION
1.	8/29/06	CHANGES MADE PER AS-BUILTS MARK UPS

SHELburne - SOUTH BURLINGTON  
 STA. 388+98 TO STA. 390+33  
 SURVEYED BY V.S.C. INC.    DATE \_\_\_\_\_  
 DRAWN BY E.A.A. INC.    DATE \_\_\_\_\_  
 TRACED BY E.A.A. INC.    DATE \_\_\_\_\_  
 PROJECT NH-EGC-019-4(28)  
 CROSS-SECTION DWG. NO. 96  
 SHEET 188R OF 283

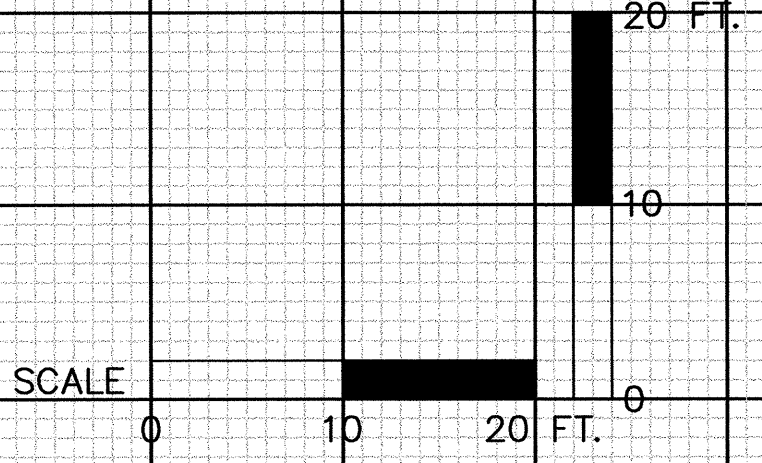

130    120    110    100    90    80    70    60    50    40    30    20    10    0    10    20    30    40    50    60    70    80    90    100    110    120