


DATUM ELEV = 150.00

DATUM ELEV = 150.00

DATUM ELEV = 150.00

DATUM ELEV = 150.00




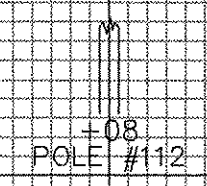


STA. 395+04.58

STA. 394+97.58


STA. 394+47.58

STA. 394+27.58

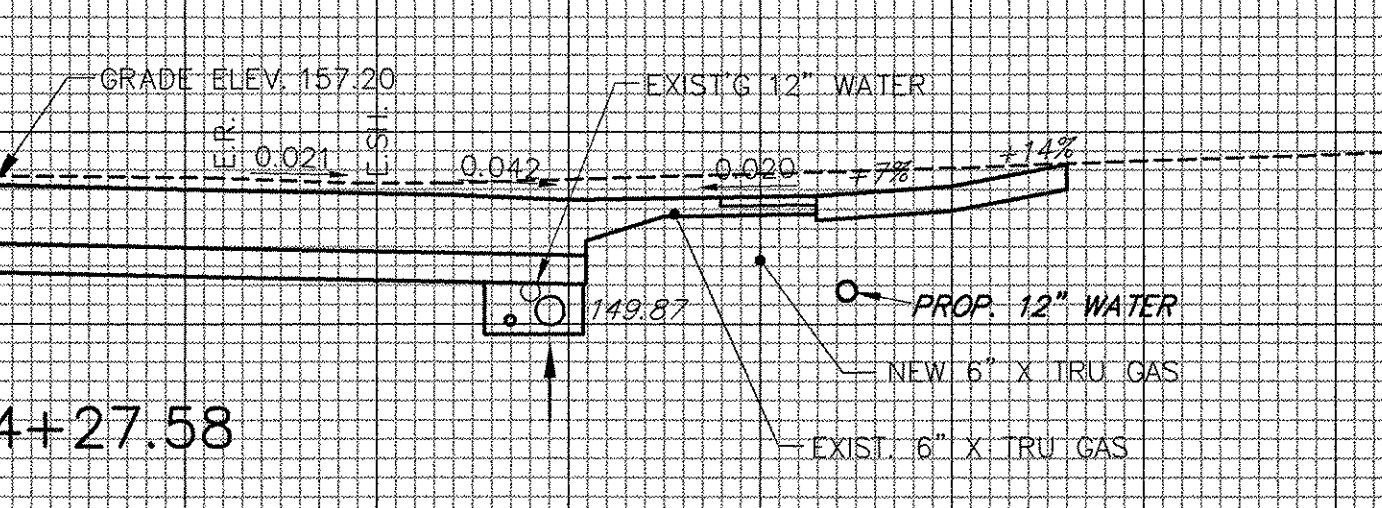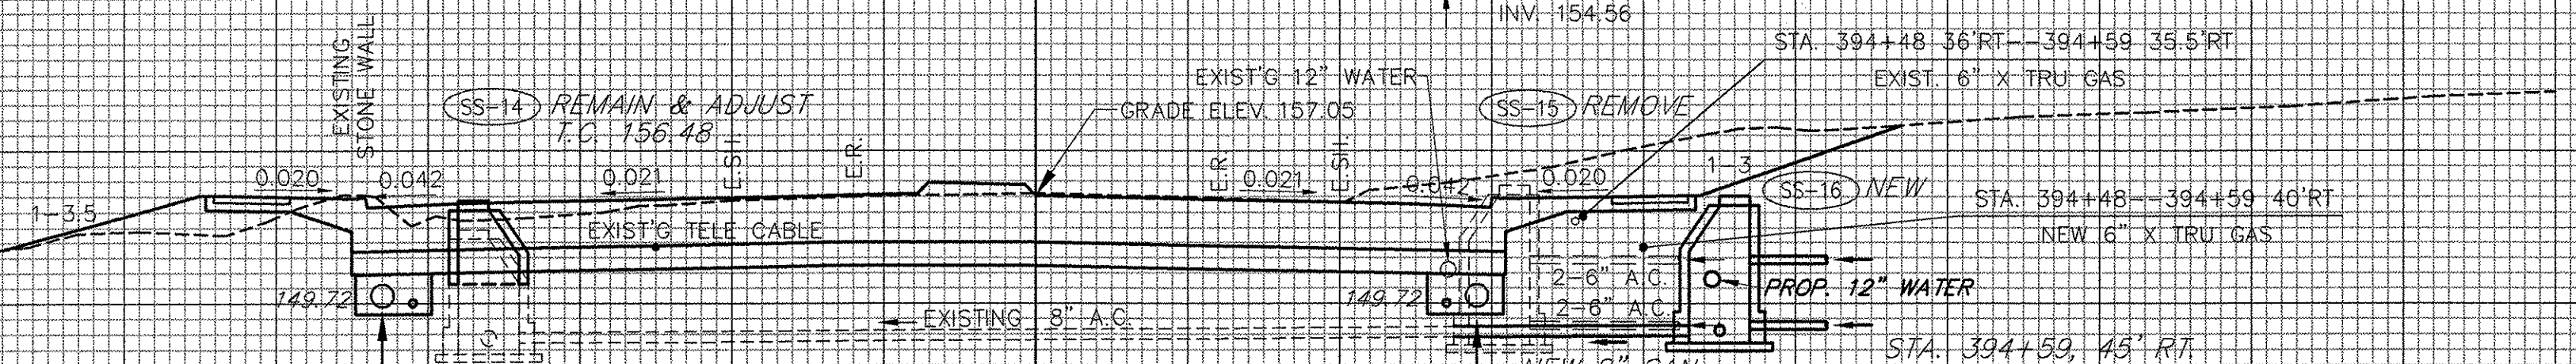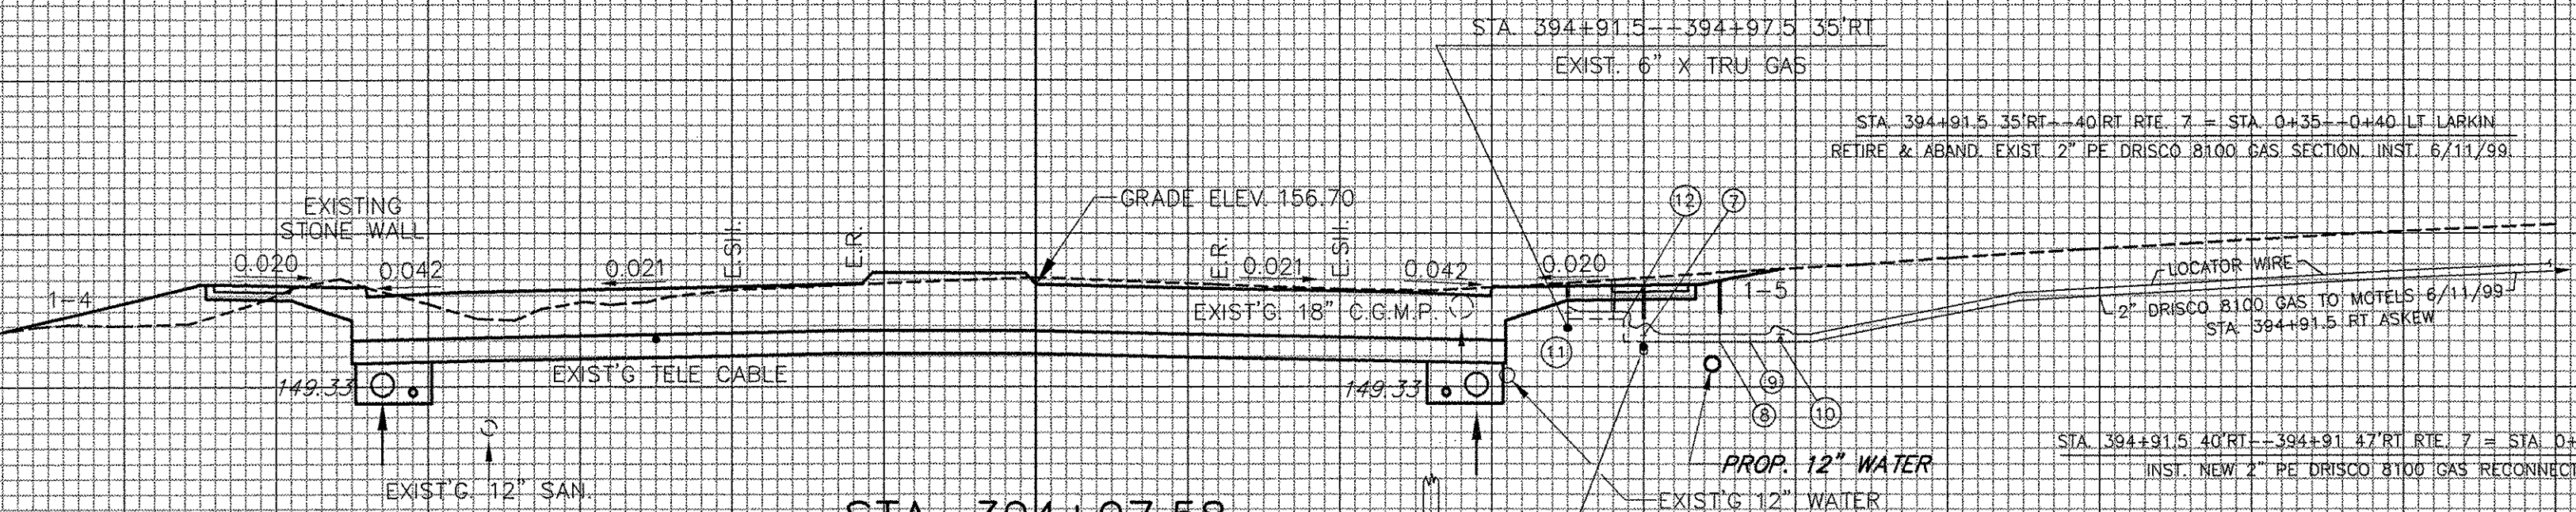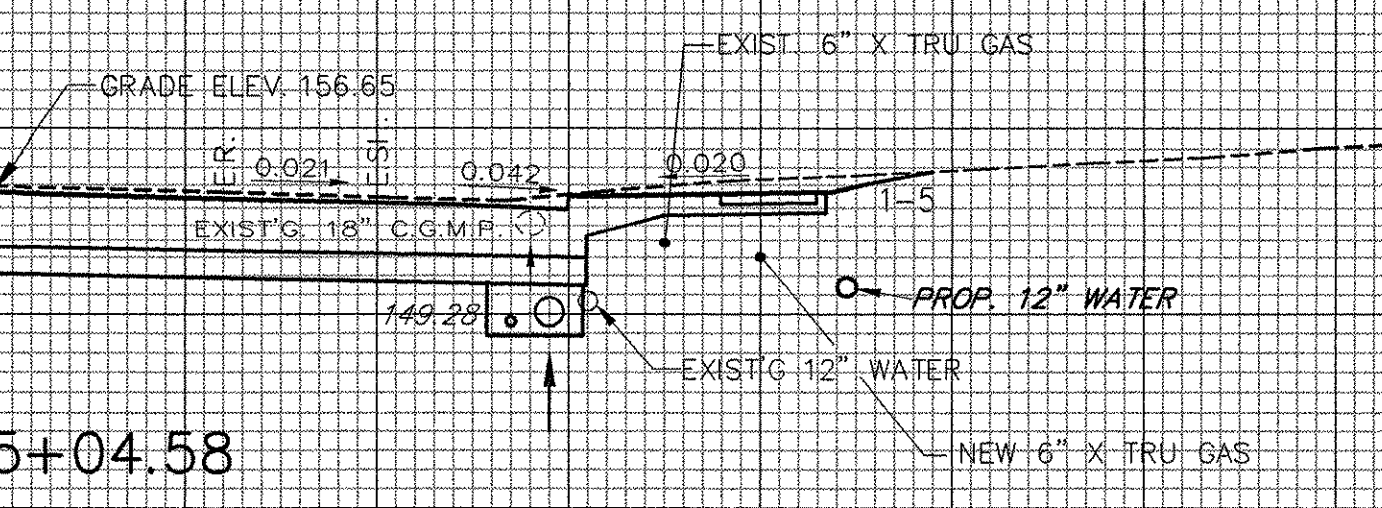

STA. 392+18--395+97 RT  
EXIST. 6" X TRU GAS TO BE RETIRED IN PLACE.  
INST. 10/69.

STA. 392+15--395+00 RT  
INST. NEW 6" X TRU GAS REPLACEMENT.

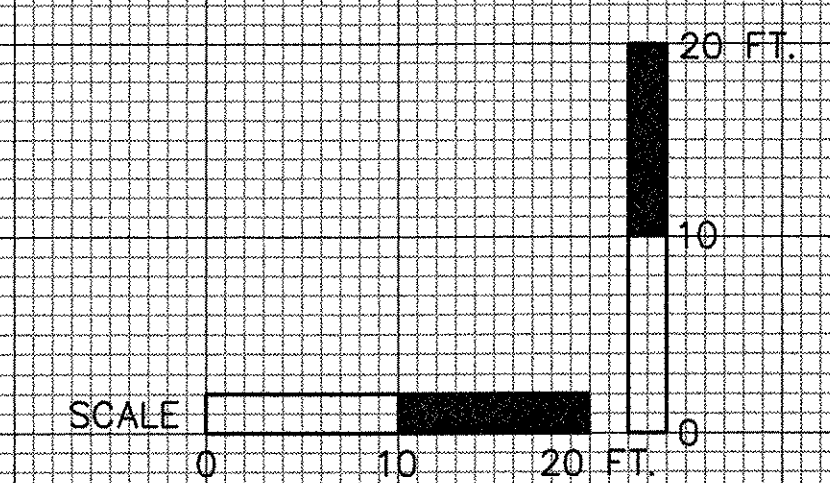

SHELBURNE -- SOUTH BURLINGTON  
STA. 394+28 TO STA. 395+05  
SURVEYED BY V.S.C. INC. DATE \_\_\_\_\_  
DRAWN BY E.A.A. INC. DATE \_\_\_\_\_  
TRACED BY E.A.A. INC. DATE \_\_\_\_\_  
PROJECT NH-EGC-019-4(28)  
CROSS-SECTION DWG. NO. 99  
SHEET 191 OF 283