

DATUM ELEV = 150.00

DATUM ELEV = 150.00


DATUM ELEV = 150.00

DATUM ELEV = 150.00

ERDMAN ANTHONY
CONSULTING ENGINEERS
Rochester, New York Camp Hill, Pennsylvania
Boston, Massachusetts

130 120 110 100 90 80 70 60 50 40 30 20 10 0 10 20 30 40 50 60 70 80 90 100 110 120

AS-BUILT REVISIONS		REVISED SEWER DESIGN
NO.	DATE	DESCRIPTION
1.	8/29/06	CHANGES MADE PER AS-BUILTS MARK UPS
	4/4/03	

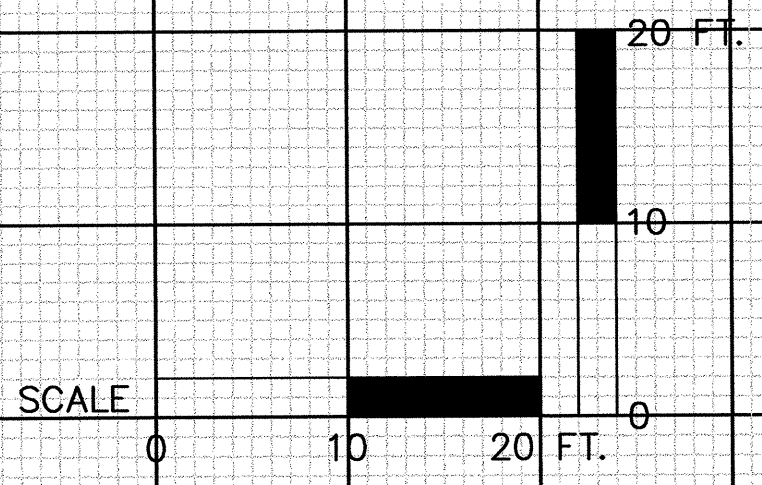

SHELBURNE - SOUTH BURLINGTON
STA. 394+28 TO STA. 395+05
SURVEYED BY V.S.C. INC. DATE _____
DRAWN BY E.A.A. INC. DATE _____
TRACED BY E.A.A. INC. DATE _____
PROJECT NH-EGC-019-4(28)
CROSS-SECTION DWG. NO. 99
SHEET 191R OF 283