

DATUM ELEV = 145.00

DATUM ELEV = 145.00

DATUM ELEV = 135.00



DATUM ELEV = 140.00

STA. 399+32.58

STA. 398+97.58

STA. 398+47.58

STA. 397+97.58

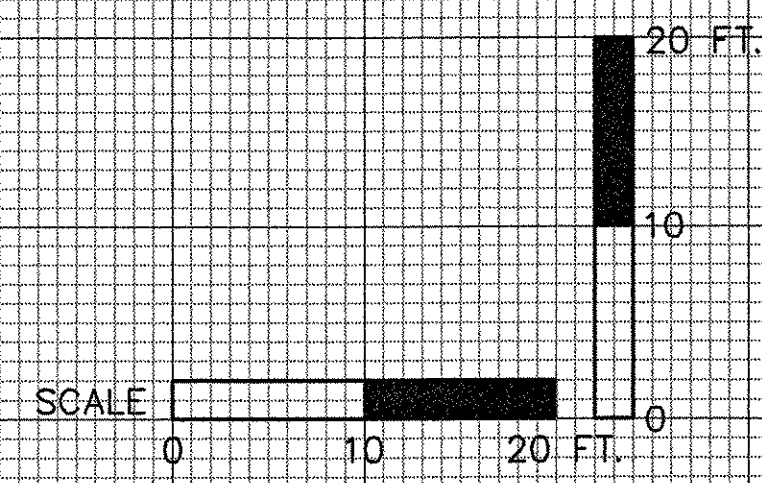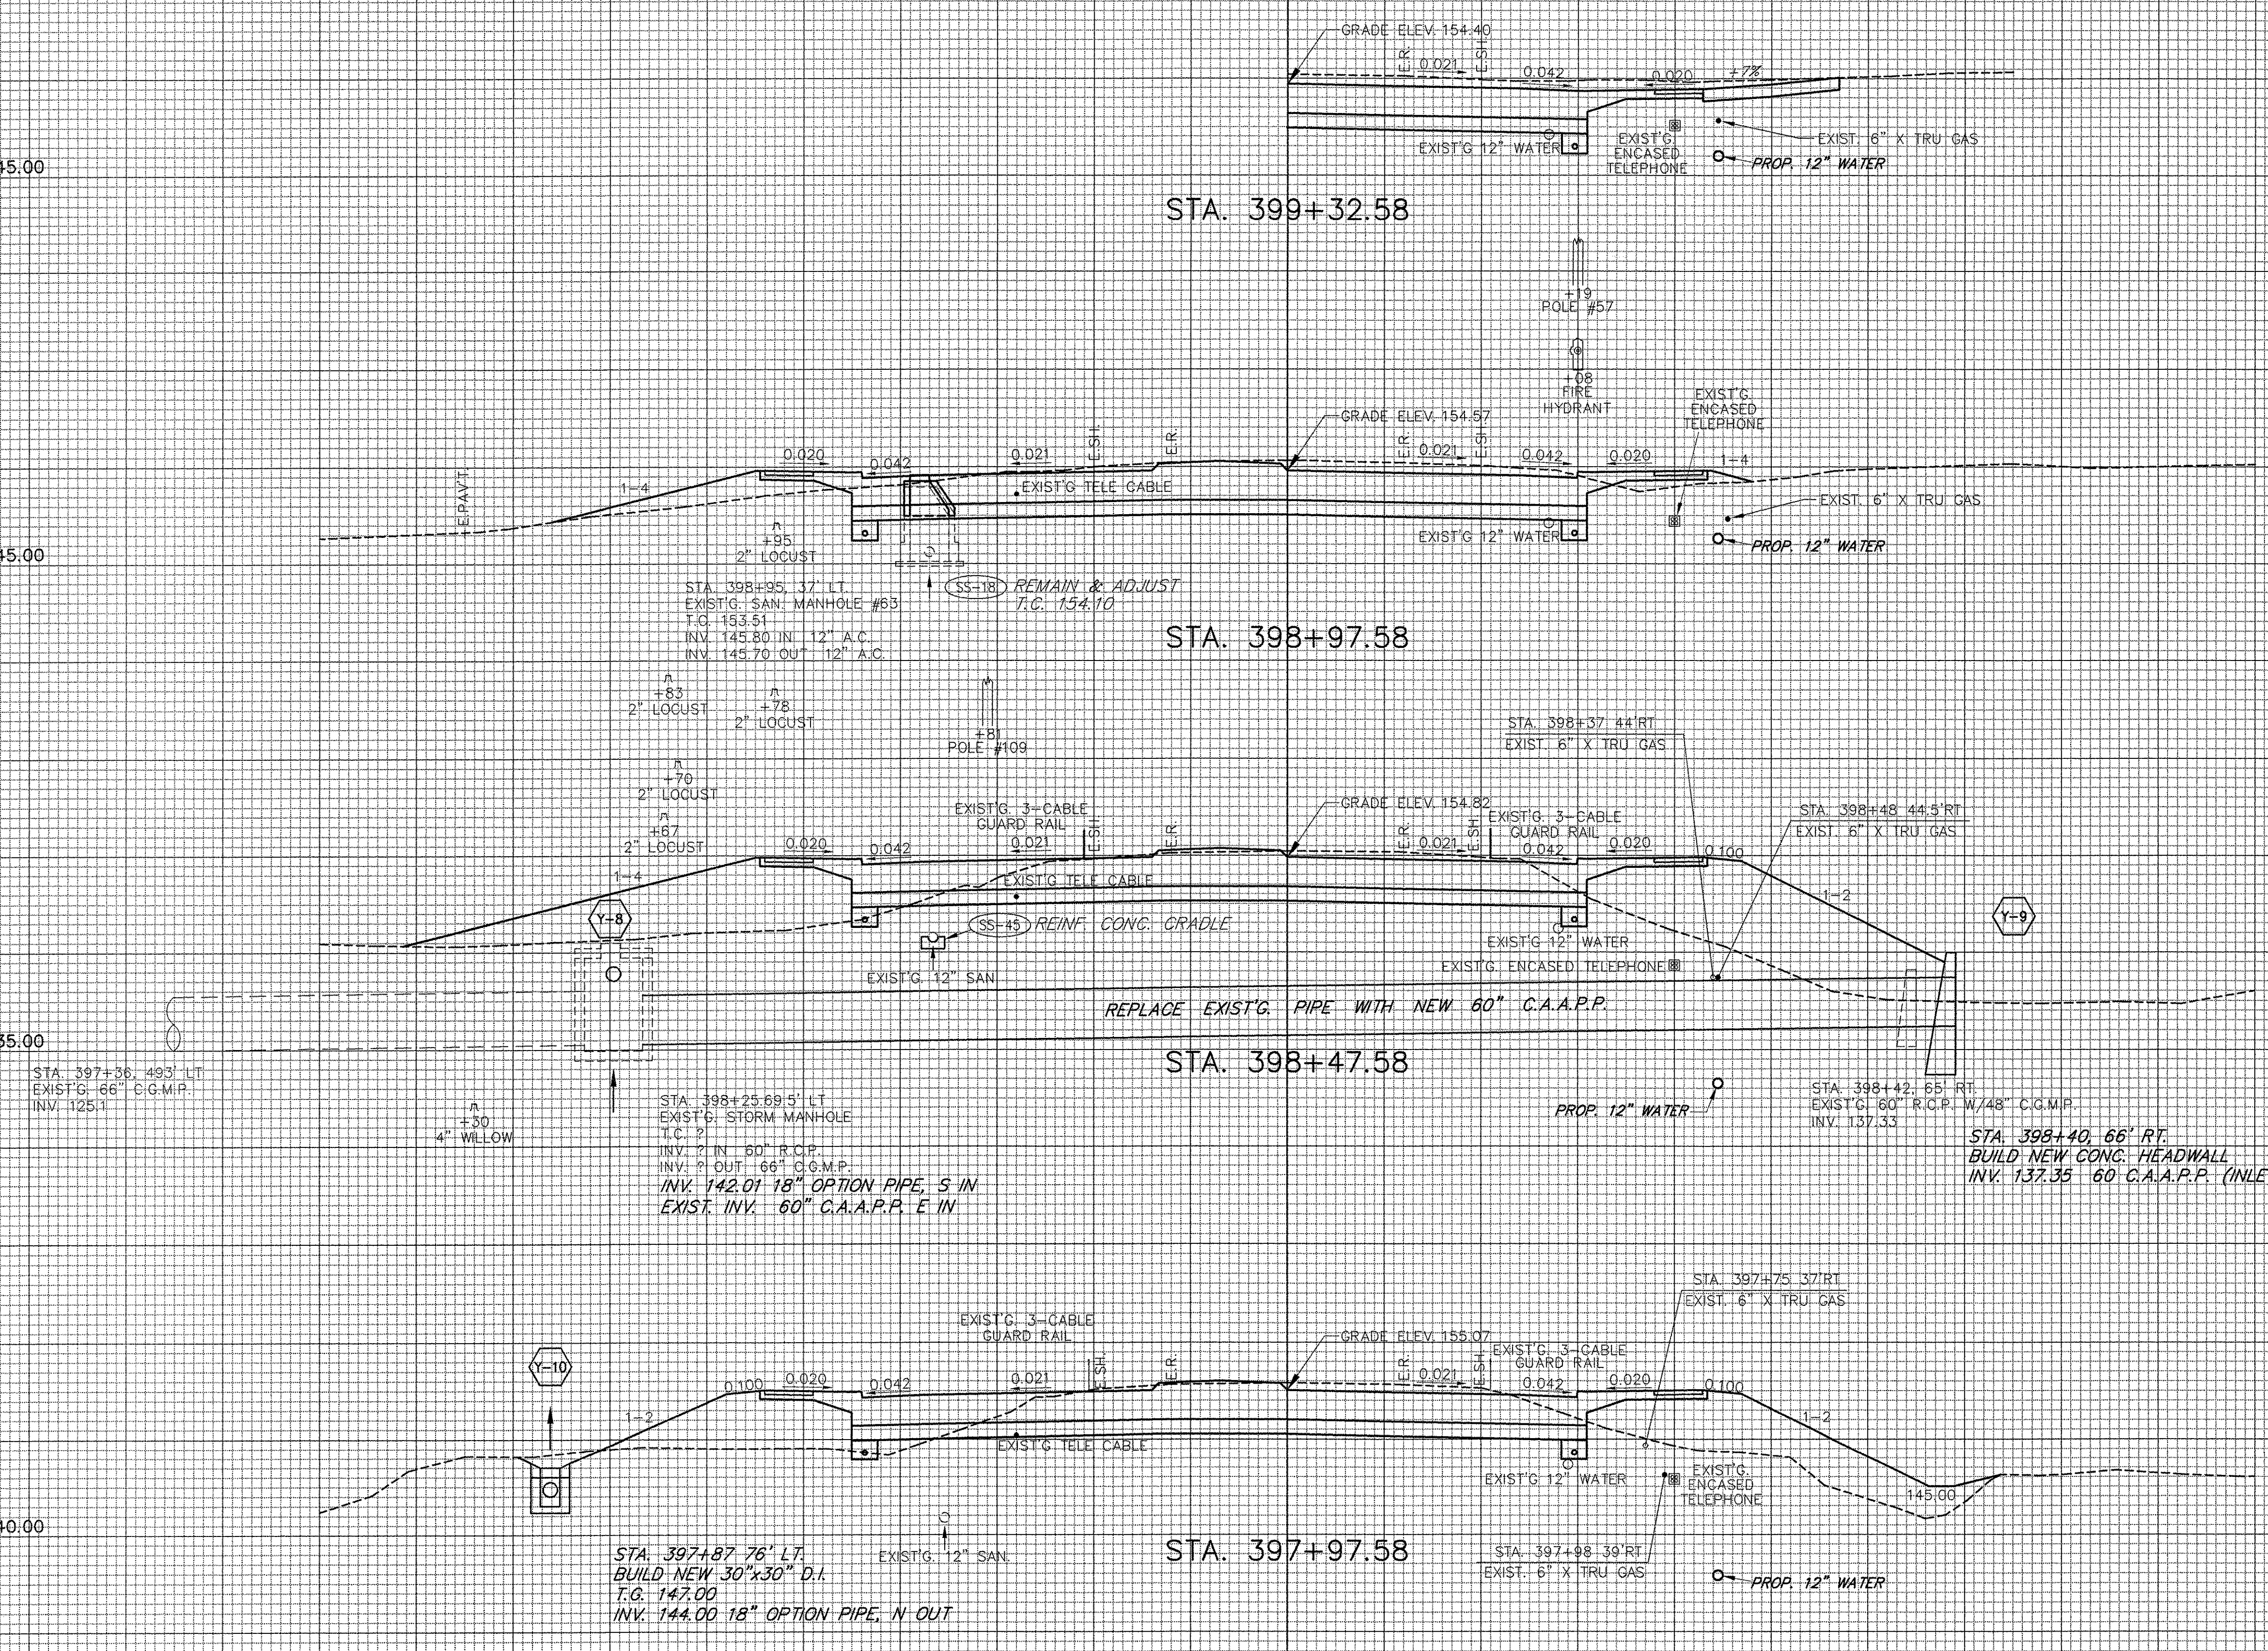

**ERDMAN ANTHONY**  
CONSULTING ENGINEERS  
Rochester, New York    Camp Hill, Pennsylvania  
Boston, Massachusetts

130    120    110    100    90    80    70    60    50    40    30    20    10    0    10    20    30    40    50    60    70    80    90    100    110    120

SHELburnE - SOUTH BURLINGTON  
**STA. 397+98 TO STA. 399+33**  
 SURVEYED BY V.S.C. INC. DATE \_\_\_\_\_  
 DRAWN BY E.A.A. INC. DATE \_\_\_\_\_  
 TRACED BY E.A.A. INC. DATE \_\_\_\_\_  
 PROJECT NH-EGC-019-4(28)  
 CROSS-SECTION DWG. NO. 102  
 SHEET 194 OF 283

4/4/03